

Physical Address: 345 Comanche St.
 Mail to: Box 384, Kiowa, CO 80117
 Ph. 303-621-8672 - Fax 303-621-7749
 www.highprairiesurvey.com

Job # 13171 Big Wampum #10

Inv # 3293


High Prairie Surveying of Kiowa, Colorado, in accordance with a request from **Wiepking Fullerton**, has determined the location of **Big Wampum #10** to be **1980 feet FSL**, and **1980 feet FWL**, (90° off Section lines) of **SECTION 23**, Township **10s**, Range **56w** of the 6th Principal Meridian, **Lincoln County**, Colorado.

Date: Staked on 07/2/14 drawn on 7/21/14.

Staked by Elijah Frane
 Drawn by Dustin Cotter

Basis of Elevation Spot: USGS BM = E 25, PID = KJ0219, H-Order = First, V-Order = First, Stability = 1.0, Sats = 8 US NAD 83 CO-C, Lat. = 39.21461, Long. = W103.60209 = 5248.17 gr. (us FT)

Notes: See Location Drawing for improvements within 500' of proposed well pad.
 The ground elevation at staked location = 5383.75' gr.
 This drawing does not represent a monumented survey or Land Survey Plat.

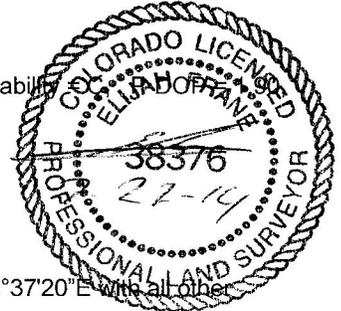

Basis of Bearing: Bearings were determined based on the North line of Section 23 to bear N88°37'20"E with all other bearings contained herein relative thereto.

