

## BMP Plan

Wiepking-Fullerton Energy, L.L.C.  
4600 S. Downing St.  
Englewood, CO 80113  
303-789-1798  
303-761-9067 (fax)

Certification to Discharge  
Under  
CDPS General Permit COR-03000  
Stormwater Discharges Associated with Construction

Certification Number COR 39788


Big Wampum # 10 well  
T10S, R56W  
Sec. 23: NE1/4SW1/4  
Lincoln County, Colorado

### Description of Well Site and Construction Area

1-3 acre site with access road for drilling of oil and gas well. Terrain is flat with native grass and sagebrush. Shallow surface water depression, which is dry, located 1959' southeast of well pad. This area will not be disturbed by drilling operations. Surface Roughening will be used on low side of drill site to reduce speed of runoff, increase infiltration, reduce erosion, trap sediment and prepare soil for reseeding. Mud and Water Pits will be reclaimed within 6 months weather permitting. Topsoil will be separated and spread on drill site as final operation before reseeding operations. To prevent soil erosion site will be disked and straw crimped in or manure spread.

Stormwater Management Plan (SWMP) is on file in Wiepking-Fullerton Energy, L.L.C. office.

Spill Prevention, Control and Countermeasure Plan are on file in Wiepking-Fullerton Energy, L.L.C. office.

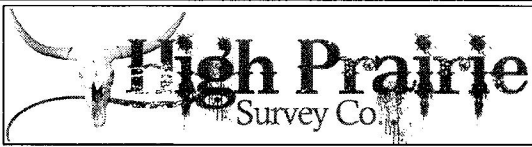

Physical Address: 345 Comanche St.  
Mail to: Box 384, Kiowa, CO 80117  
Ph. 303-621-8672 - Fax 303-621-7749  
www.highprairiesurvey.com

Job # 13171 Big Wampum #10

Inv # 3293


High Prairie Surveying of Kiowa, Colorado, in accordance with a request from Wiepking Fullerton, has determined the location of **Big Wampum #10** to be **1980 feet FSL**, and **1980 feet FWL**, (90° off Section lines) of **SECTION 23**, Township **10s**, Range **56w** of the 6th Principal Meridian, **Lincoln County**, Colorado.

Date: Staked on 07/2/14 drawn on 7/21/14.

Re: Staked by Elijah Frane

Drawn: Drawn by Dustin Cotter

## Topo Exhibit

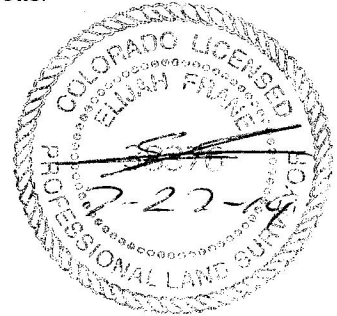

Wiepking Fullerton  
SW 1/4 Sec. 23-10s-56w  
Big Wampum #10  
Lincoln County, Colorado

