

**WPX Energy Rocky Mountain LLC**

**FEDERAL NER 443-32**


**RULISON Field**

**SHL 161' FNL 2596' FWL (SE/4 NW/4) LOT 2 Section 5 T7S R93W 6th PM**

**BHL 1454' FSL 627' FEL (NE/4 SE/4) Section 32 T6S R93W 6th PM**

**Garfield County Colorado**

**Formation Tops**  
(Measured Depths)

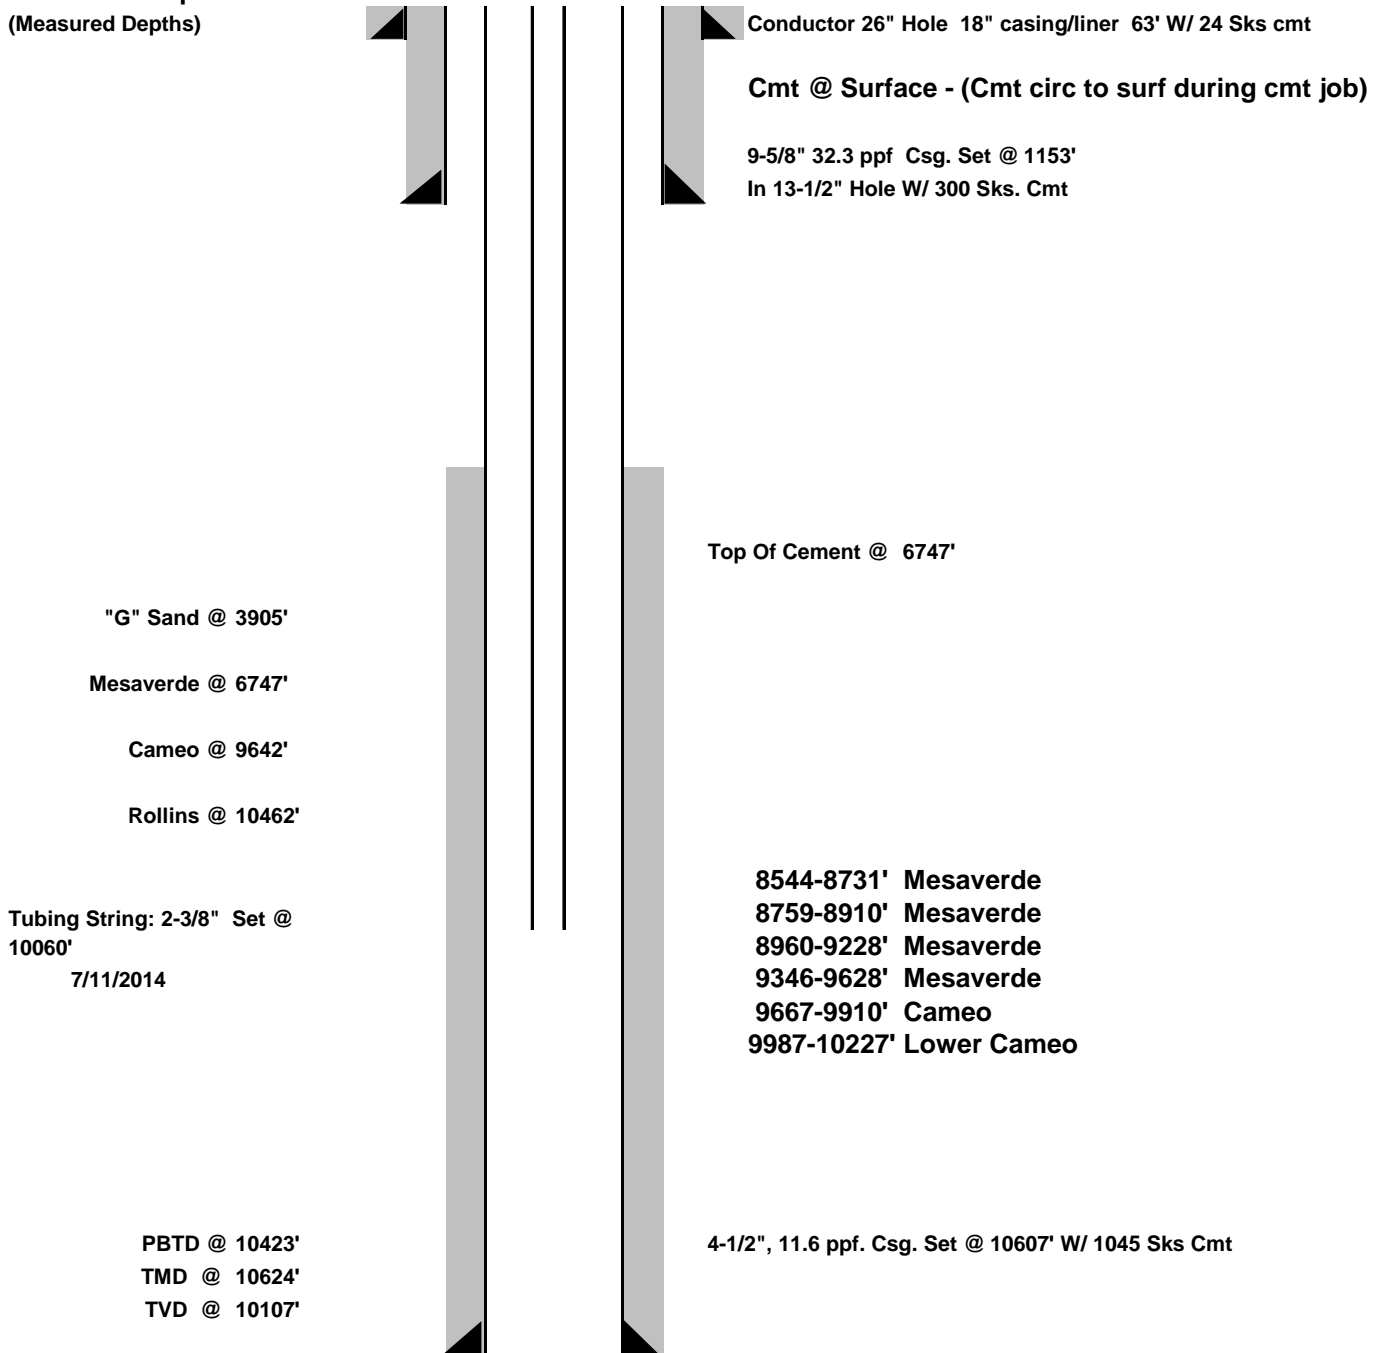

**DATE CREATED:** 7.22.2014

**NOTE: THIS IS NOT TO SCALE.**  
**\*\*FINAL\*\***