


WELL NAME: West Crow Hill #14-26
OPERATOR: Carrizo Oil & Gaas
COMP ZONE: N/A
LOCATION: 8N 61W S26 SW SW

COUNTY: Weld
STATE: Colorado
API : 05-123-19620

SPUD: 6/3/98
P&A: 7/9/14
GL: 5,001'

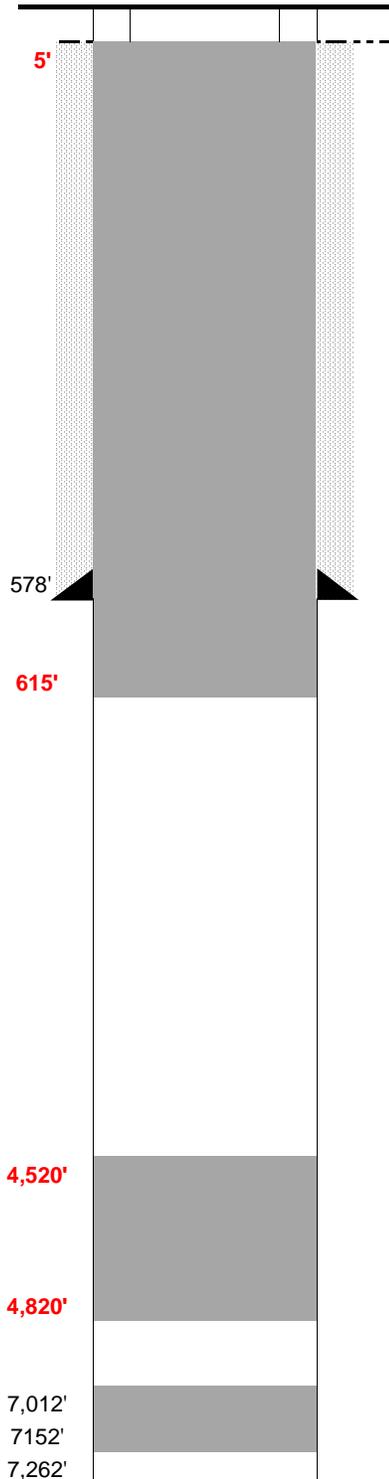

SURFACE CASING

DEPTH: 578' SIZE: 8.625" GRADE: _____ WT (#/ft): 24.0
 CEMENT: 200 sx
 COMMENTS: _____

PRODUCTION CASING

DEPTH: _____ SIZE: _____ GRADE: _____ WT (#/ft): _____
 CEMENT: _____ TOC: _____
 COMMENTS: _____

PERFS: _____ - _____ PROD ZONE 1: _____
 PERFS: _____ - _____ ZONE 2: _____
 PERFS: _____ - _____ ZONE 3: _____

PREVIOUS PLUGS

RECOVERED: _____ SIZE: _____
 CMT 1: 7,152' - 7,012' COMMENT: 40 sx cement
 CMT 2: 665' - 490' COMMENT: 50 sx cement
 CMT 3: 35' - 4' COMMENT: 10 sx cement

AS PLUGGED: Plug #1: 300' cement plug from 4,820' to 4,520' (100 sx)
Plug #2: Cement plug from 615' to surface to isolate FW sands (300 sx)

FORMATIONS:

NIOBRARA: 6,400'
 FORT HAYS 6,630'
 CODELL 6,658'
 D SAND 7,083'
 D SILT _____
 J SAND 7,154'