

CURRENT WELLBORE DIAGRAM

Stegas 23-15 #1

NESW Sec. 15-11S-53W 6PM


API #: 05-073-06271

Pronghorn Operating LLC (#10422)

Lincoln Cty, CO

Drilled & Abandoned by Murfin Drilling in 1993

8-5/8" 24# csg @ 517'
Cmt to surface w/ 310 sx

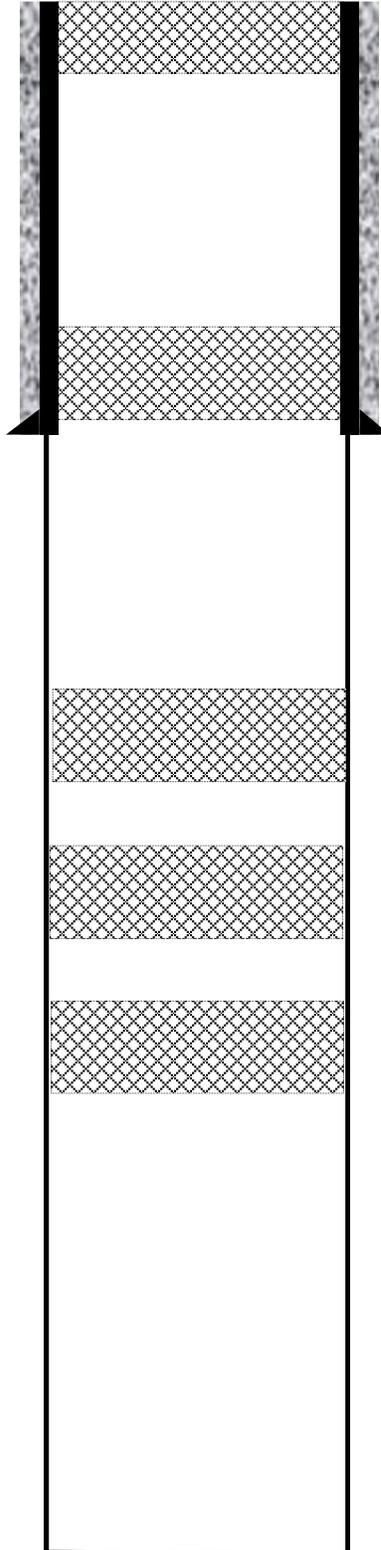

15 SK Cement Plug 0'-23' 8/30/1992

35 SK Cement Plug 380' - 432" 8/30/1992

40 SK Cement Plug 1912' - 2045' 8/30/1992

40 SK Cement Plug 4000' - 4100"

40 SK Cement Plug 6600' - 6700'

7-7/8" Hole @ 7270' TD


PROPOSED WELLBORE DIAGRAM

Stegas 23-15 #1 NESW Sec. 15-11S-53W 6PM
Pronghorn Operating LLC (#10422)

API #: 05-073-06271
Lincoln Cty, CO

Re-Entry Objective: Drill out cement plugs to original TD, run & cement 5.5" casing, perforate & test multiple objectives

8-5/8" 24# csg @ 517'
Cmt to surface w/ 310 sx

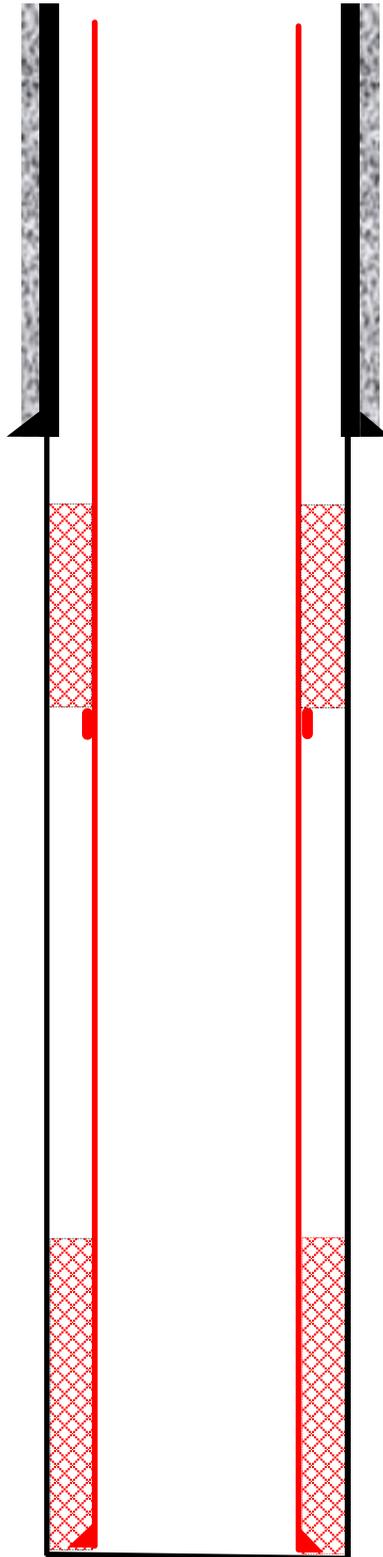

Stage Tool:
requirements

*TBD per APD stage cement

Est TOC

5500'

7-7/8" Hole @ 7270' TD

5.5" 15# casing @ 7270' cemented with
200 sx CMT