




Lat40°, Inc. 1635 Foxtrail Drive, Suite 325 Loveland, CO 970-776-3321


LATITUDE & LONGITUDE EXHIBIT

JOHNSON 01N-65W-30 PAD

SECTION: 30
TOWNSHIP: 1N
RANGE: 65W

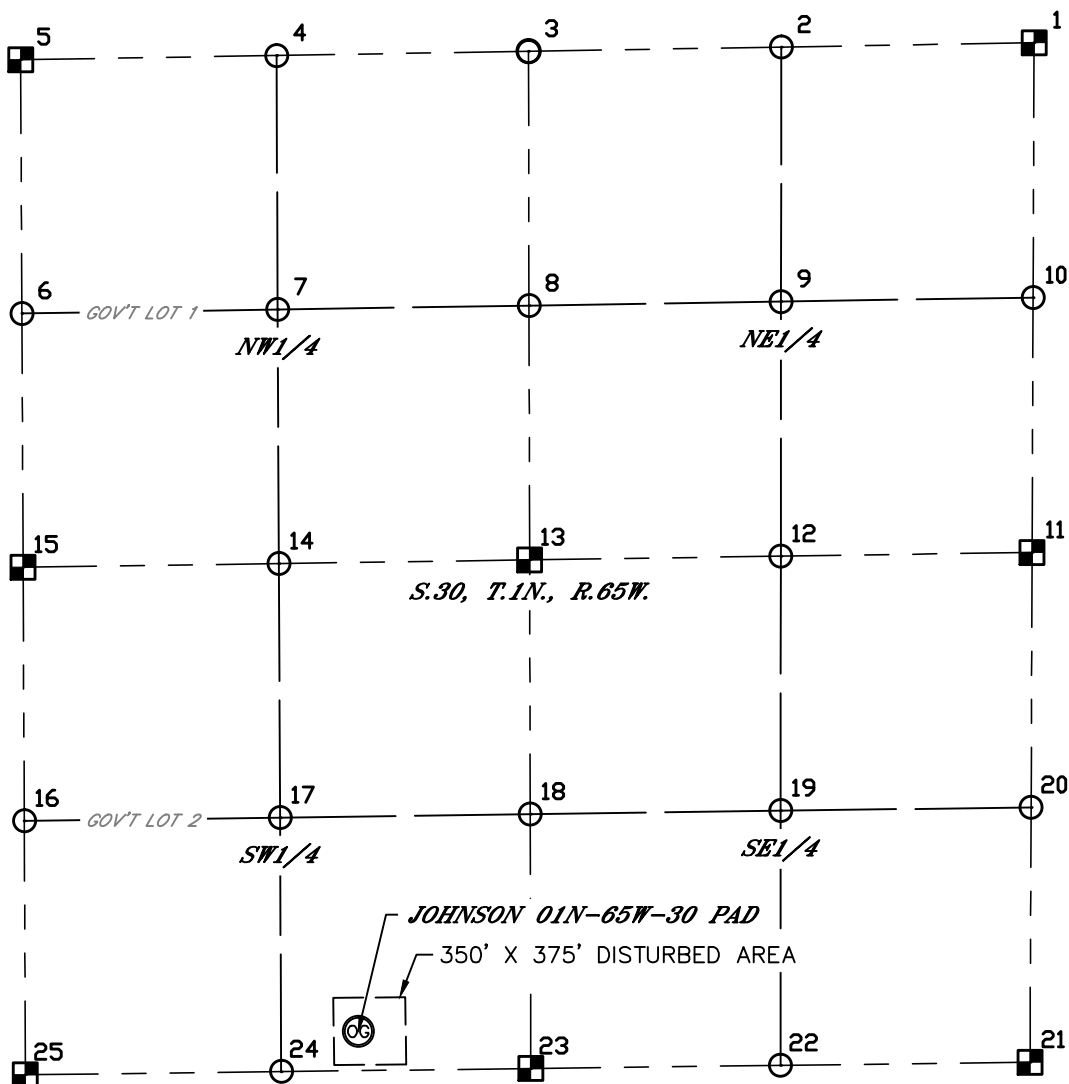

NOTE
THE QUARTER-QUARTER LOCATIONS SHOWN HEREON WERE SUBDIVIDED BY PROTRACTION. NO ATTEMPT HAS BEEN MADE TO LOCATE ACTUAL 1/16TH CORNER MONUMENTATION PER CLIENTS REQUEST.

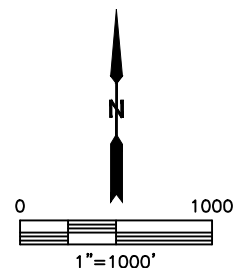

LEGEND

- = FOUND ALIQUOT MONUMENT
- = CALCULATED POSITION



Lat40°, Inc. 1635 Foxtrail Drive, Suite 325 Loveland, CO 970-776-3321

LATITUDE & LONGITUDE EXHIBIT

JOHNSON 01N-65W-30 PAD

SECTION: 30
TOWNSHIP: 1N
RANGE: 65W

#	LATITUDE°	LONGITUDE°
1	40.02965	-104.69723
2	40.02962	-104.70193
3	40.02959	-104.70663
4	40.02957	-104.71132
5	40.02954	-104.71607
6	40.02591	-104.71609
7	40.02594	-104.71134
8	40.02596	-104.70666
9	40.02599	-104.70198
10	40.02601	-104.69729
11	40.02237	-104.69735
12	40.02235	-104.70202
13	40.02233	-104.70670
14	40.02231	-104.71136
15	40.02229	-104.71611
16	40.01866	-104.71613
17	40.01868	-104.71138
18	40.01869	-104.70673
19	40.01871	-104.70207
20	40.01873	-104.69742
21	40.01509	-104.69748
22	40.01507	-104.70212
23	40.01506	-104.70676
24	40.01505	-104.71140
25	40.01504	-104.71615