




Lat40, Inc. 1635 Foxtrail Drive, Suite 325 Loveland, CO 970-776-3321

# WELL LOCATION CERTIFICATE


SECTION: 1  
TOWNSHIP: 9N  
RANGE: 58W

THIS MAP DOES NOT REPRESENT A BOUNDARY SURVEY

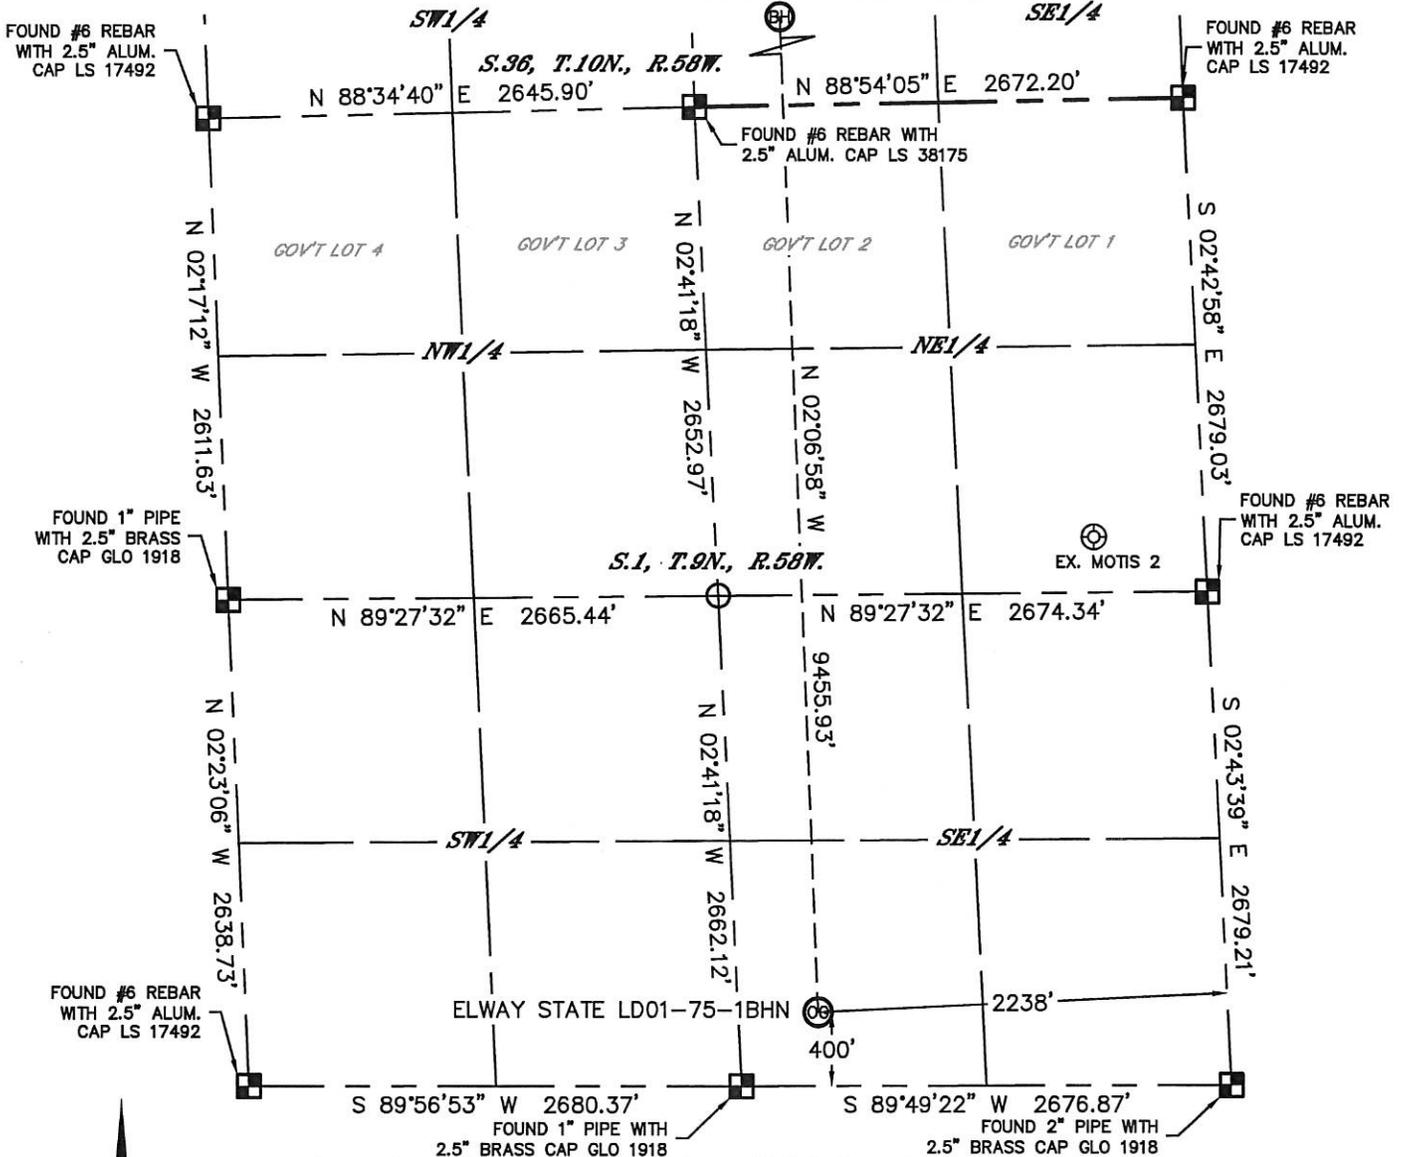

In accordance with a request from Brian James with Noble Energy Inc., Lat40, Inc. has determined the surface location of the ELWAY STATE LD01-75-1BHN to be 400' from the SOUTH line and 2238' from the EAST line as measured at right angles from the section lines of Section 1, Township 9 North, Range 58 West and the bottom hole to be 810' from the NORTH line and 2200' from the EAST line as measured at right angles from the section lines of Section 36, Township 10 North, Range 58 West of the Sixth Principal Meridian, County of Weld, State of Colorado.

I hereby state that this Well Location Certificate was prepared by me, or under my direct supervision, that the fieldwork was completed on 9/9/2013, for and on behalf of Noble Energy Inc. That this is not a Land Survey Plat or an Improvement Survey Plat, and that it is not to be relied upon for establishment of fence, building, or other future improvement lines.

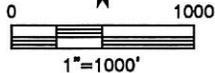


NOTE:

- 1) Bearings shown are Grid Bearings of the Colorado State Plane Coordinate System, North Zone, North American Datum 1983/2007. The lineal dimensions as contained herein are based upon the "U.S. Survey Foot."
- 2) Ground elevations are based on an observed GPS elevation (NAVD 1988 DATUM).
- 3) IMPROVEMENTS: See LOCATION DRAWING for all visible improvements within 500' of disturbed area.
- 4) SURFACE USE: RANGELAND
- 5) INSTRUMENT OPERATOR: BRIAN ROTTINGHAUS
- 6) NEAREST EXISTING WELL: MOTIS 2, 2987' NE  
NEAREST CULTURAL ITEMS:  
BUILDING: 5280'+  
BUILDING UNIT: 5280'+  
HIGH OCCUPANCY BUILDING UNIT: 5280'+  
DESIGNATED OUTSIDE ACTIVITY AREA: 5280'+  
PUBLIC ROAD: 5280'+  
ABOVEGROUND UTILITY: 5280'+  
RAILROAD: 5280'+  
PROPERTY LINE: 400' S

**SURFACE LOCATION**  
LAT: 40.77431N  
LONG: 103.81041W  
PDOP: 1.8  
ELEV: 4633'  
1/4, 1/4: SW1/4SE1/4

**BOTTOM HOLE**  
LAT: 40.80026N  
LONG: 103.81102W

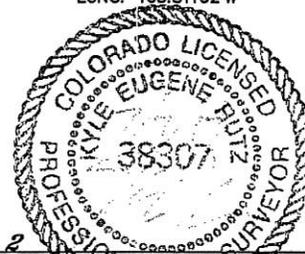

LEGEND

- = ALIQUOT MONUMENT AS DESCRIBED
- = CALCULATED POSITION

**SHEET 1 OF 2**

Kyle E. Rutz—On behalf of Lat40, Inc.  
Colorado Licensed Professional Land Surveyor No. 38307  
DATE: 7/7/2014  
PROJECT#: 2013115





Lat40°, Inc. 1635 Foxtrail Drive, Suite 325 Loveland, CO 970-776-3321

# WELL LOCATION CERTIFICATE

THIS MAP DOES NOT REPRESENT A BOUNDARY SURVEY

SECTION: 1  
TOWNSHIP: 9N  
RANGE: 58W

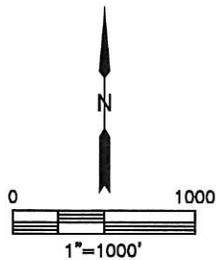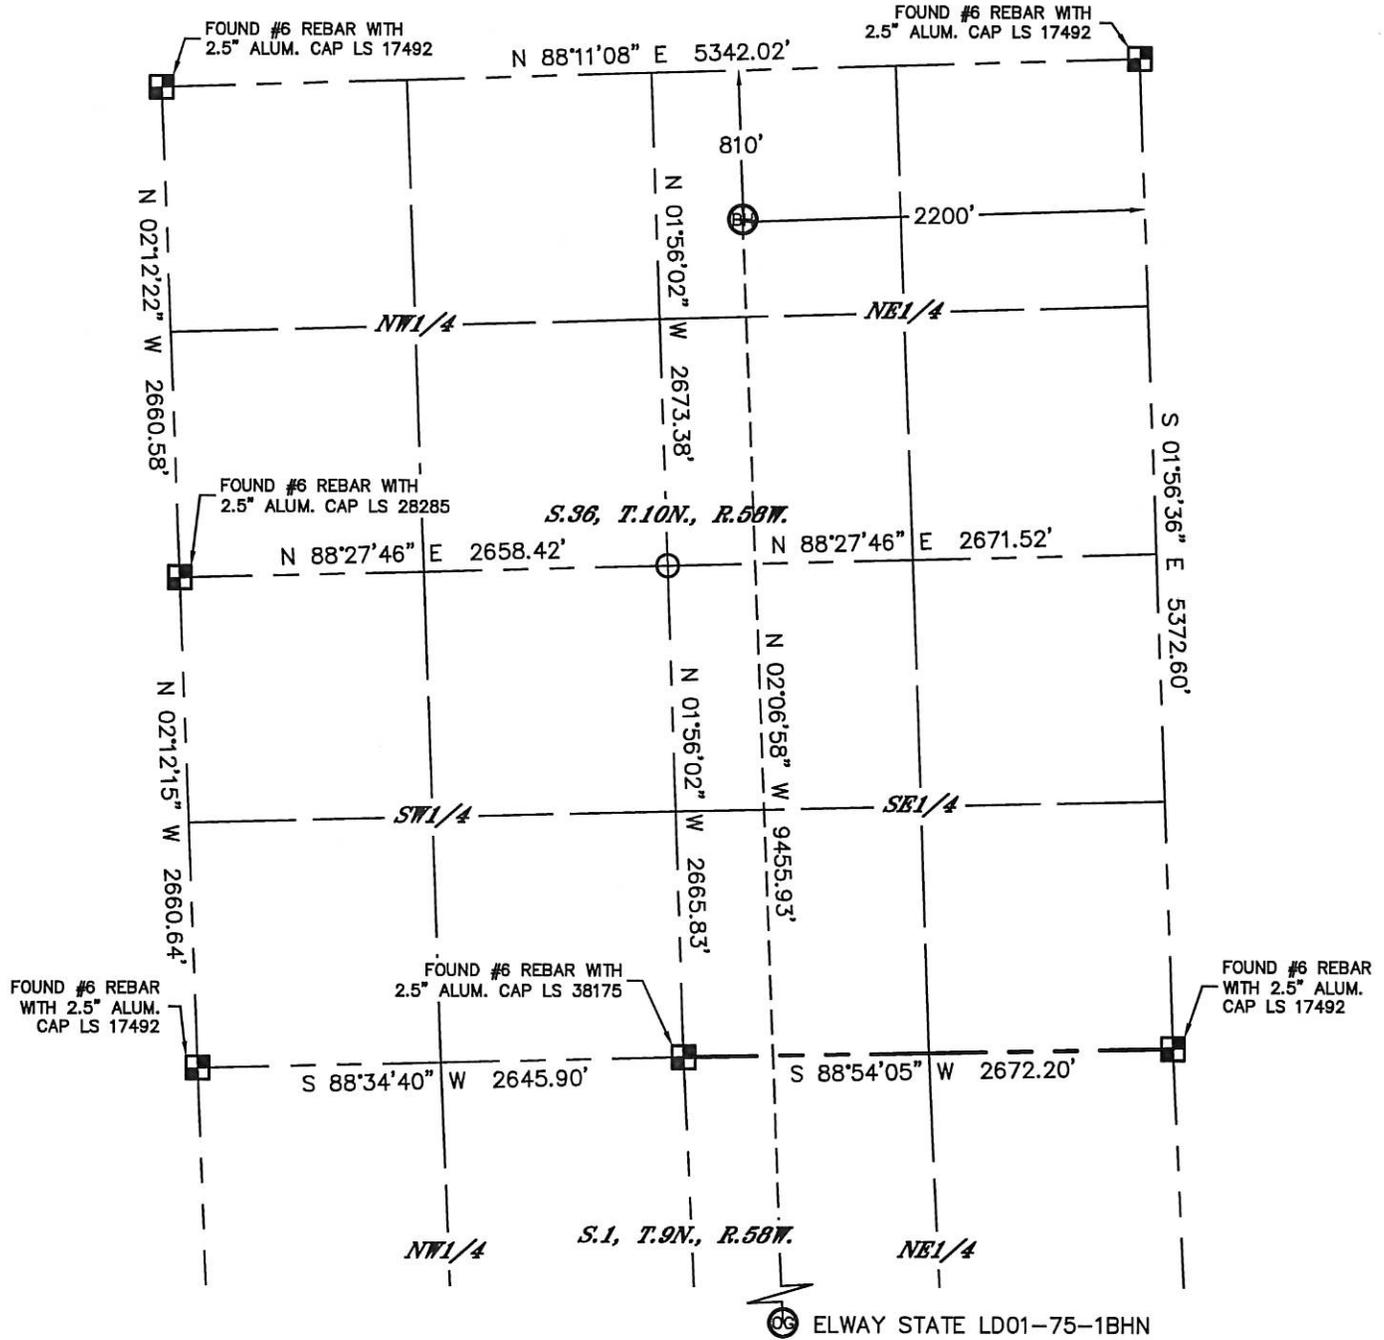

- LEGEND
- = ALIQUOT MONUMENT AS DESCRIBED
  - = CALCULATED POSITION



**SHEET 2 OF 2**  
 Kyle E. Rutz—On behalf of Lat40, Inc.  
 Colorado Licensed Professional  
 Land Surveyor No. 38307  
 DATE: 7/7/2014  
 PROJECT#: 2013115




Lat40°, Inc. 1635 Foxtrail Drive, Suite 325 Loveland, CO 970-776-3321


# SITE SKETCH

ELWAY STATE LD01-75-1BHN

SECTION: 1  
TOWNSHIP: 9N  
RANGE: 58W

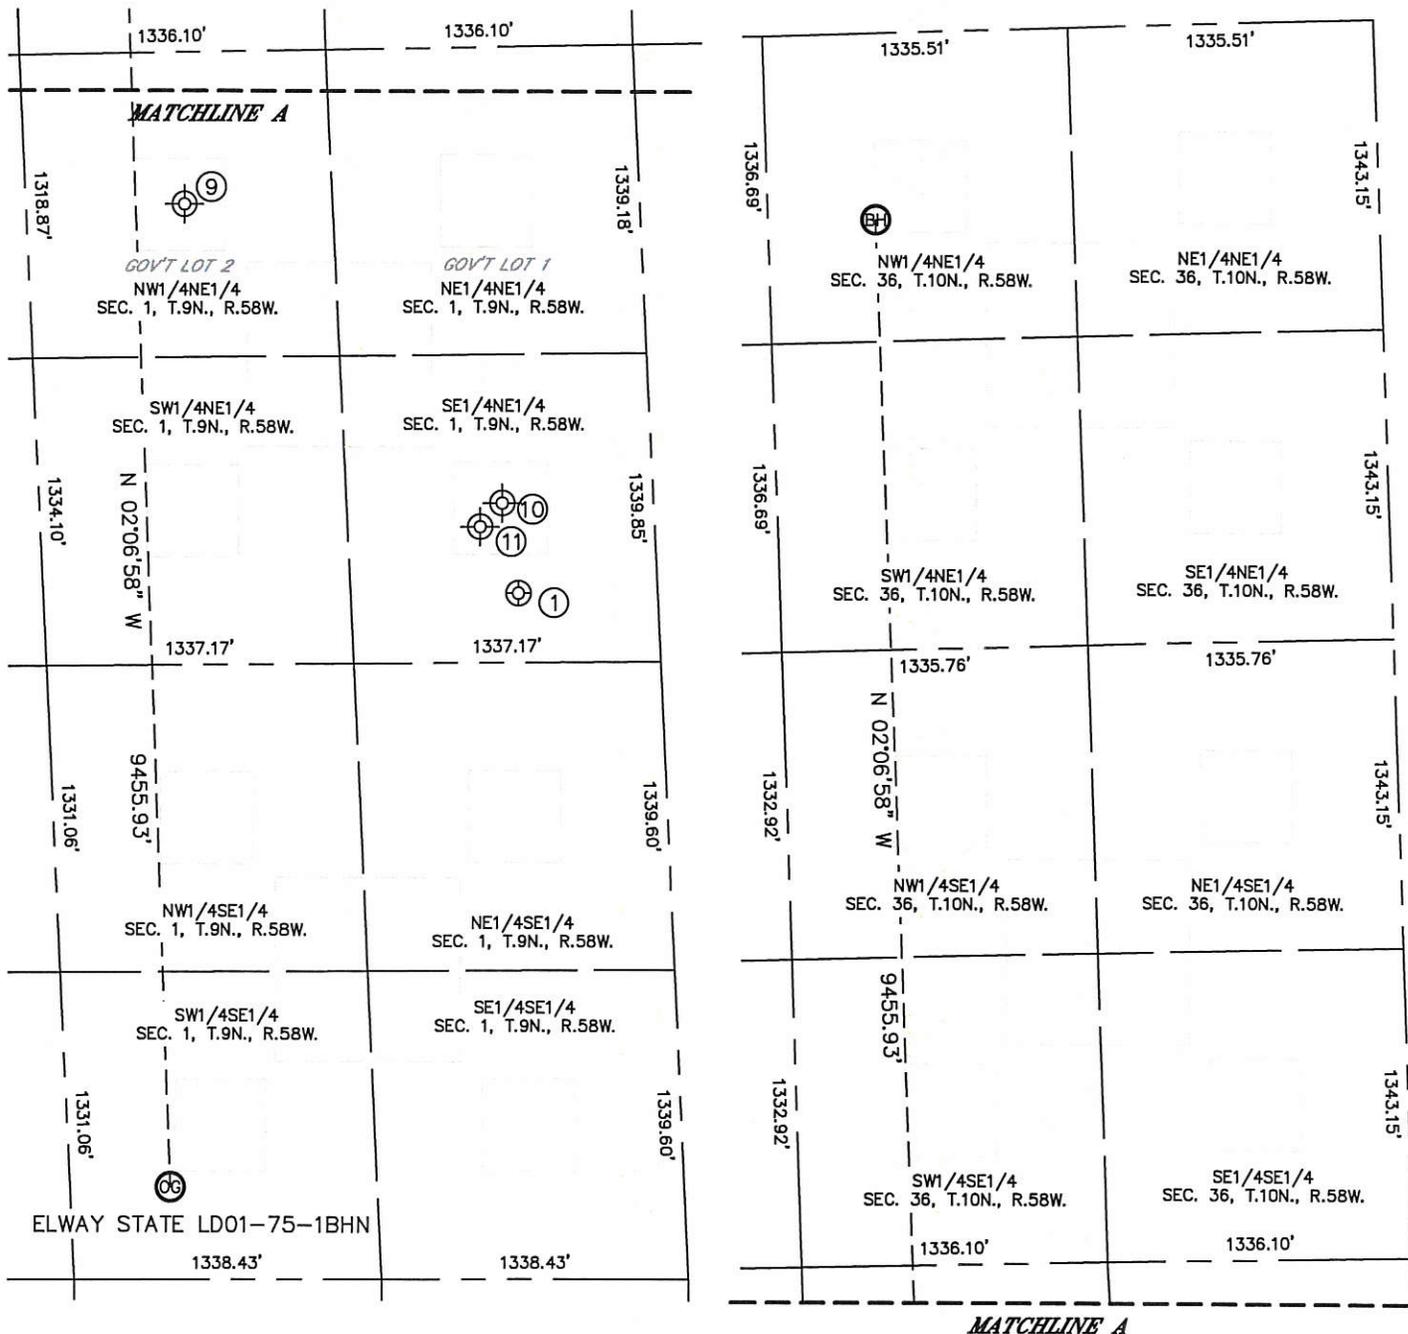

WELL NO.	WELL NAME	SHL FOOTAGE			SHL LAT°	SHL LONG°	PDOP	ELEV. (FT.)	1/4/1/4	
1	MOTIS 2	2372	FNL	607	FEL	40.78131	-103.80479	1.6	4667	SENE
9	MOTIS 1	660	FNL	1980	FEL	40.78599	-103.80991	NA	4670	NWNE
10	MOTIS 1	1980	FNL	660	FEL	40.78238	-103.80504	NA	4665	SENE
11	KUHN 1	2080	FNL	760	FEL	40.78210	-103.80539	NA	NA	SENE

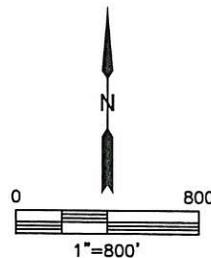

NOTE: THE ABANDONED WELL DATA SHOWN IN RED ABOVE WAS OBTAINED FROM COGCC SCOUT CARDS.

DATE: 7/7/2014  
PROJECT#: 2013115