


KERR-MCGEE OIL AND GAS ONSHORE LP
CARL ADLER GAS UNIT B 2
SW NW 2 2N 68W -- --
WELD,COLORADO
08/13/2014

AREA: W1 ROUTE: W12 Spud: 09/21/1979 WINS No.: 74333 AFE/WO#: 2077539 API#: 0512309779

GL: 4826 KB: 4837 MTD: 7860 TVD: 7860 LOG MD: 7861 PBMD: 7841 PBTVD: 7841

Directions: CR 24 1/2 & CR 9 3/4, W 3/10, N 2/10, W 21/0, S INTO.

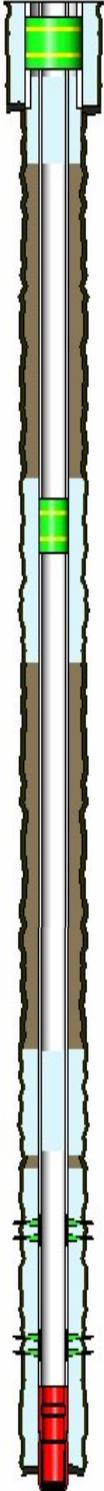

<u>HOLE SECTIONS</u>	<u>Size</u>	<u>Top</u>	<u>Btm</u>	<u>TD Date</u>					
SURFACE	12.25	10	427	09/23/1979					
PRODUCTION	7.88	427	7885	10/02/1979					
<u>TUBULARS</u>	<u>Tool Type</u>	<u>Joints</u>	<u>Size</u>	<u>Weight</u>	<u>Grade</u>	<u>Thread</u>	<u>Top D</u>	<u>Bottom D</u>	
SURFACE CASING	Casing	10	8.63	24.00	K-55	STC	11	427	
PRODUCTION CASING	Casing	193	4.50	10.50	K-55	STC	11	7883	
	Float Collar	1	4.50				7883	7884	
	Casing Guide Shoe	1	4.50				7884	7885	
CAST IRON CEMENT RETAINER	Cement Retainer		4.50				3870	3872	
BRIDGE PLUG	Cast Iron Bridge Plu	1	8.63				80	82	
<u>CEMENT JOBS</u>	<u>Stage</u>	<u>Sacks</u>	<u>Cement Jobs</u>	<u>Top D</u>	<u>Btm D</u>	<u>cbf</u>			
SURFACE CASING	STAGE 1	350	REGULAR	11	427	No			
PRODUCTION CASING	STAGE 1	200	50/50 POZ-MIX	7064	7885	No			
PRODUCTION CASING	SQUEEZE JOB	150	LEAD NIOBRARA SQUEEZE	6450	7000	Yes			
PRODUCTION CASING	ABANDONMENT PLUC	30	LEAD FRESH WATER	6461	6970	No			
PRODUCTION CASING	ABANDONMENT PLUC	560	LEAD FRESH WATER	3685	4440	No			
SURFACE CASING	ABANDONMENT PLUC	350	LEAD FRESH WATER	145	910	No			
<u>PERFORATIONS</u>	<u>Formation</u>	<u>Zone</u>	<u>Top</u>	<u>Btm</u>	<u>Date</u>	<u>Reason</u>	<u>Comments</u>		
	SUSSEX		3840	3841	07/08/3014	CEMENT SQUEEZE			
	SUSSEX		4440	4441	07/08/3014	CEMENT SQUEEZE			
	NIOBRARA		7040	7041	03/03/2010	CEMENT SQUEEZE			
	CODELL		7308	7324	08/15/1995	PRODUCTION	4 SPF		
	J SAND		7748	7772	02/10/1980	PRODUCTION	2 SPF		

Comments: