




# Exploration and Production

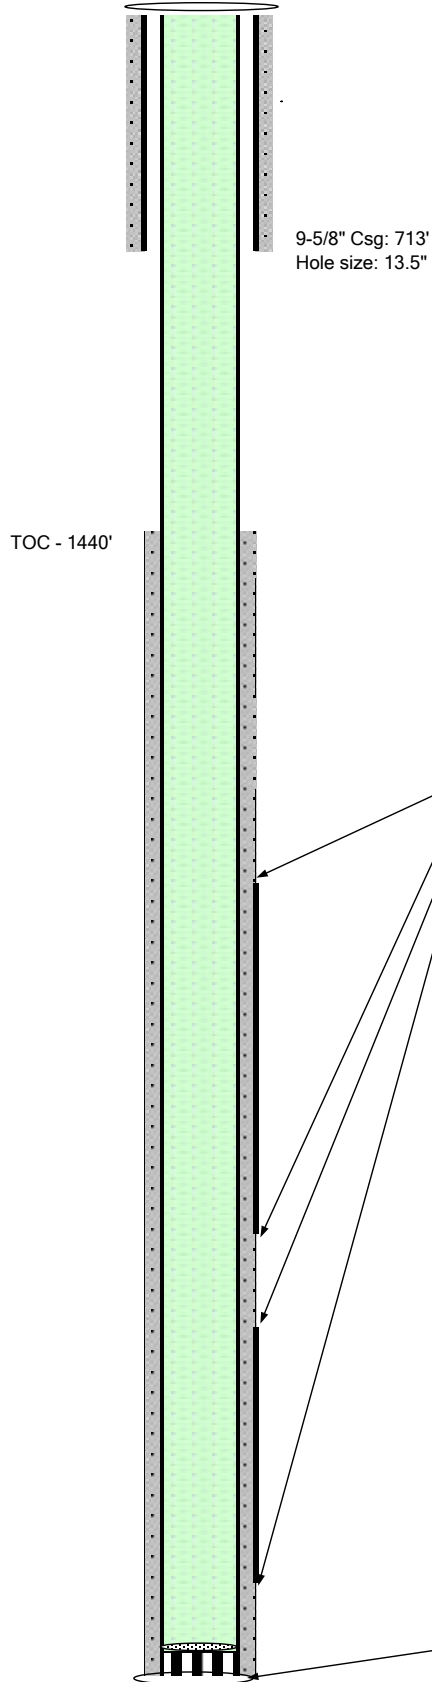

Well Name **GM 247-1**  
 Location **NESE 1-7S-96W**  
 Field **South Grand Valley**  
 County **Garfield, CO**  
 API **05-045-07744**  
 ELEV **5,350'**  
 Footages **1859 FSL 1137 FEL**

## Spud 06/26/2001

Conductor	<b>713'</b>	<b>9-5/8" 32.3#</b>
Casing	380 sx	Class G
Cement	<b>6506'</b>	<b>4-1/2" 11.6# N-80</b>
Casing	885 sx	Class G

Tubing **6097'**

## Formation Tops

Mesaverde	4818'
Cameo	6092'

TOC - Bond Log **1440'**

## Completed Intervals

	<u>Depth</u>	<u># Holes</u>
<u>MV</u>	4818' - 5968'	50
<u>Cameo</u>	6092' - 6359'	16

## Cement Squeezes

<u>Depth</u>	<u># Holes</u>	<u>Sks</u>
4818-4910'	12	200
4818-4910'	12	50
4818-4910'	12	20

**6506', 4-1/2" Csg, Hole Size, 7-7/8"**

TD