

KERR-MCGEE OIL AND GAS ONSHORE LP

UPRR 42 PAN AM AO 1

NE NE 35 2N 67W 990' FNL 1,160' FEL

WELD,COLORADO

08/11/2014

AREA: W1

ROUTE: W17 Spud: 11/25/1977

WINS No.: 74498

AFE/WO#: 88521437

API#: 0512309344

GL: 4940

KB: 4950

MTD: 8150

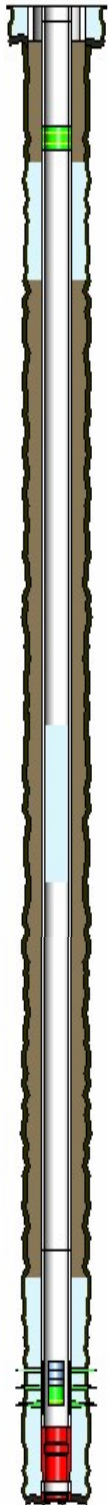
TVD: 8150

LOG MD: 8150

PBMD: 8100

PBTVD: 8100

Directions:

WCR 14-1/2 & WCR 23, N 4/10, WEST 3/10 INTO THROUGH YARD, TRAVEL THROUGH GREEN GATE
6/10.

HOLE SECTIONS	Size	Top	Btm	TD Date
SURFACE	12.25	10	217	11/25/1977
PRODUCTION	7.88	217	8150	12/07/1977

TUBULARS	Tool Type	Joints	Size	Weight	Grade	Thread	Top D	Bottom D
SURFACE CASING	Casing	5	8.63	24	K-55	STC	10	216
PRODUCTION CASING	Casing	2	4.50	11.60	K-55	STC	10	92
	Casing	20	4.50	10.50	K-55	STC	92	724
	Cement Stage Too	1	4.50				724	725
	Casing	207	4.50	10.50	K-55	STC	725	7326
	Casing	19	4.50	11.60	K-55	STC	7326	8114
	Casing Float Collar	1	4.50				8114	8115
	Casing	1	4.50	11.60	K-55	STC	8115	8149
	Casing Guide Shoe	1	4.50				8149	8150
PRODUCTION TUBING	Tubing	256	2.38	4.70	J-55	8RD EUE	10	8003
	Seating Nipple	1	2.38				8003	8004
	Notched Collar	1	2.38				8004	8005

CEMENT JOBS	Stage	Sacks	Cement Jobs	Top D	Btm D	cbl
SURFACE CASING	STAGE 1	200	G	10	217	No
PRODUCTION CASING	STAGE 1	250	50/50 POZ-MIX	7500	8150	No
PRODUCTION CASING	ONE INCH JOB	550	LEAD FRESH WATER	4180	5120	No
PRODUCTION CASING	SQUEEZE JOB	800	LEAD FRESH WATER	80	1500	No

PERFORATIONS	Formation	Zone	Top	Btm	Date	Reason	Comments
J SAND			8000	8044	04/07/1978	PRODUCTION	Perf using Vann System

Comments: