



Physical Address: 345 Comanche St.  
Mail to: Box 384 Kiowa, CO 80117  
Ph. 303-621-8672 - Fax 303-621-7749  
www.highprairiesurvey.com

Job # 14226 Easy Come #1

Inv # 3335

High Prairie Surveying of Kiowa, Colorado has in accordance with a request from Wiepking Fullerton Energy LLC has determined the location of EASY COME #1 to be 620 feet FNL, and 853 feet FEL, (90° off Section lines) of SECTION 2, Township 6s, Range 54w of the 6th Principal Meridian, Lincoln County, Colorado.


Date: Staked on 07/21/14 drawn on 08/05/14.

Re:

Staked by Elijah Frane

Drawn:

Drawn by Dustin Cotter

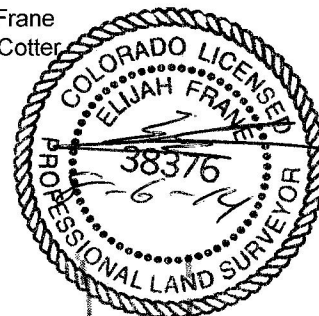

## Location Drawing

There are no apparent improvements within 500' of the proposed well pad.

Wiepking Fullerton Energy LLC  
NE 1/4 SEC. 2-6S-54W  
EASY COME #1  
LINCOLN, Co. COLORADO

CR 0 51

