


KERR-MCGEE OIL AND GAS ONSHORE LP
SARCHET JOHN E UNIT 1
SW SW 22 3N 66W 990' FSL 990' FWL
WELD,COLORADO
08/14/2014

AREA: N1 ROUTE: N15 Spud: 01/11/1972 WINS No.: 74889 AFE/WO#: 88585681 API#: 0512307389

GL: 4922 KB: 4931 MTD: 7980 TVD: 7980 LOG MD: PBMD: 7940 PBTVD: 7940

Directions: WCR 32 & WCR 31, S 7/10, E&S 2/10 INTO

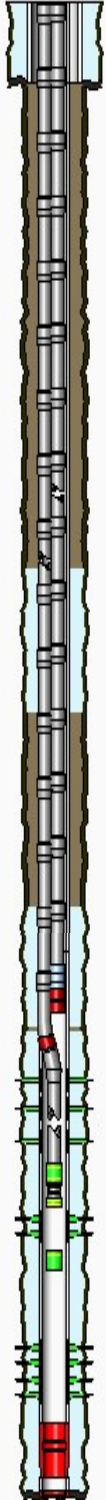

HOLE SECTIONS	Size	Top	Btm	TD Date
SURFACE	12.25	9	575	01/11/1972
PRODUCTION	7.88	575	7980	01/20/1972

TUBULARS	Tool Type	Joints	Size	Weight	Grade	Thread	Top D	Bottom D
SURFACE CASING	Casing	19	8.63	24	K-55	ST&C	9	571
PRODUCTION CASING	Casing	2	4.50	11.60	K-55	ST&C	9	76
	Casing	203	4.50	10.50	K-55	ST&C	76	6678
	Casing	39	4.50	11.60	K-55	ST&C	6678	7951
	Float Collar	1	4.50				7951	7953
	Casing	1	4.50	11.60	K-55	ST&C	7953	7978
	Casing Shoe	1	4.50				7978	7979
SAND PLUG	Sand Plug						7450	7450
PRODUCTION TUBING	Tubing	215	2.38	4.70	J-55	External-Ups	9	6772
	Seating Nipple	1	2.38				6772	6773
	Wellbore Equipment	1					6773	6774
	Wellbore Equipment	1					6774	6775
PRODUCTION TUBING	Tubing	221	2.38	4.70	J-55	8RD EUE	9	6958
	Wellbore Equipment	1					6958	6964
	Tubing	11	2.38	4.70	J-55	8RD EUE	6964	7311
	XN Profile Nipple	1					7311	7312
	Tubing	1	2.38	4.70	J-55	8RD EUE	7312	7344
	Notched Collar	1			J-55		7344	7344

CEMENT JOBS	Stage	Sacks	Cement Jobs	Top D	Btm D	cbl
SURFACE CASING	STAGE 1	575	REGULAR	9	575	No
PRODUCTION CASING	STAGE 1	300	50/50 POZMIX	6924	7979	Yes
PRODUCTION CASING	SQUEEZE JOB	100	LEAD FRESH WATER	6364	6880	Yes
PRODUCTION CASING	PRIM CMT 1ST STAGE	390	LEAD FRESH WATER	3990	5000	No

PERFORATIONS	Formation	Zone	Top	Btm	Date	Reason	Comments
	NIOBRARA	A	7110	7114	09/21/2011	PRODUCTION	
	NIOBRARA	B	7148	7158	09/21/2011	PRODUCTION	
	NIOBRARA	C	7228	7238	09/21/2011	PRODUCTION	
	CODELL		7374	7390	07/16/1996	PRODUCTION	
	J SAND		7826	7840	01/31/1971	PRODUCTION	
	J SAND		7826	7840	05/27/1978	PRODUCTION	
	J SAND		7852	7876	01/31/1971	PRODUCTION	
	J SAND		7852	7876	05/27/1978	PRODUCTION	

Comments: