

SWEVCO-SABW


Federal J-29-3-101-S

API # 05-103-08600

Date: 17-JUL-2014

As Plugged

By: TSF

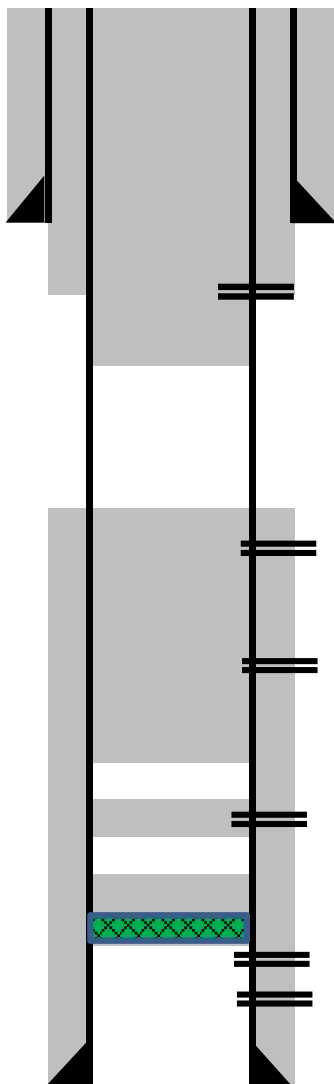

Top off w/ 30 sx.

8.75" Hole, 7" 23# @ 175' KB. Cemented w/ 100 sx class G
w/ 2% CaCl, 0.25#/sk Flocele
Squeeze perf @ 225' w/ 80 sx circulated to surface in both
4.5" casing and 7" X 4.5" annulus

Bottom of cement @ 276' inside casing

TOC @ 367'

Squeeze holes @ 500'

Squeeze holes @ 950'

Bottom of cement @ 1,467'

Squeeze holes @ 2,000'
Cement from 1,783' - 2,050'

CIBP @ 2,830' w/ 3 sx cement
Emery: 2,862' – 3,145', Select fire, 24 holes

4.5" 10.5# @ 3,369'
TD = 3,387', PBTD = 3,369'