





Lat40°, Inc. 1635 Foxtrail Drive, Suite 325 Loveland, CO 970-776-3321

PLUGGED & ABANDONED WELL EXHIBIT

THIS MAP DOES NOT REPRESENT A BOUNDARY SURVEY

SECTION: 24
TOWNSHIP: 5N
RANGE: 61W

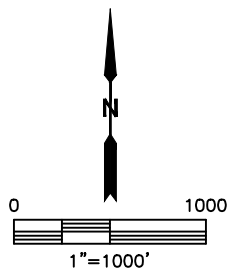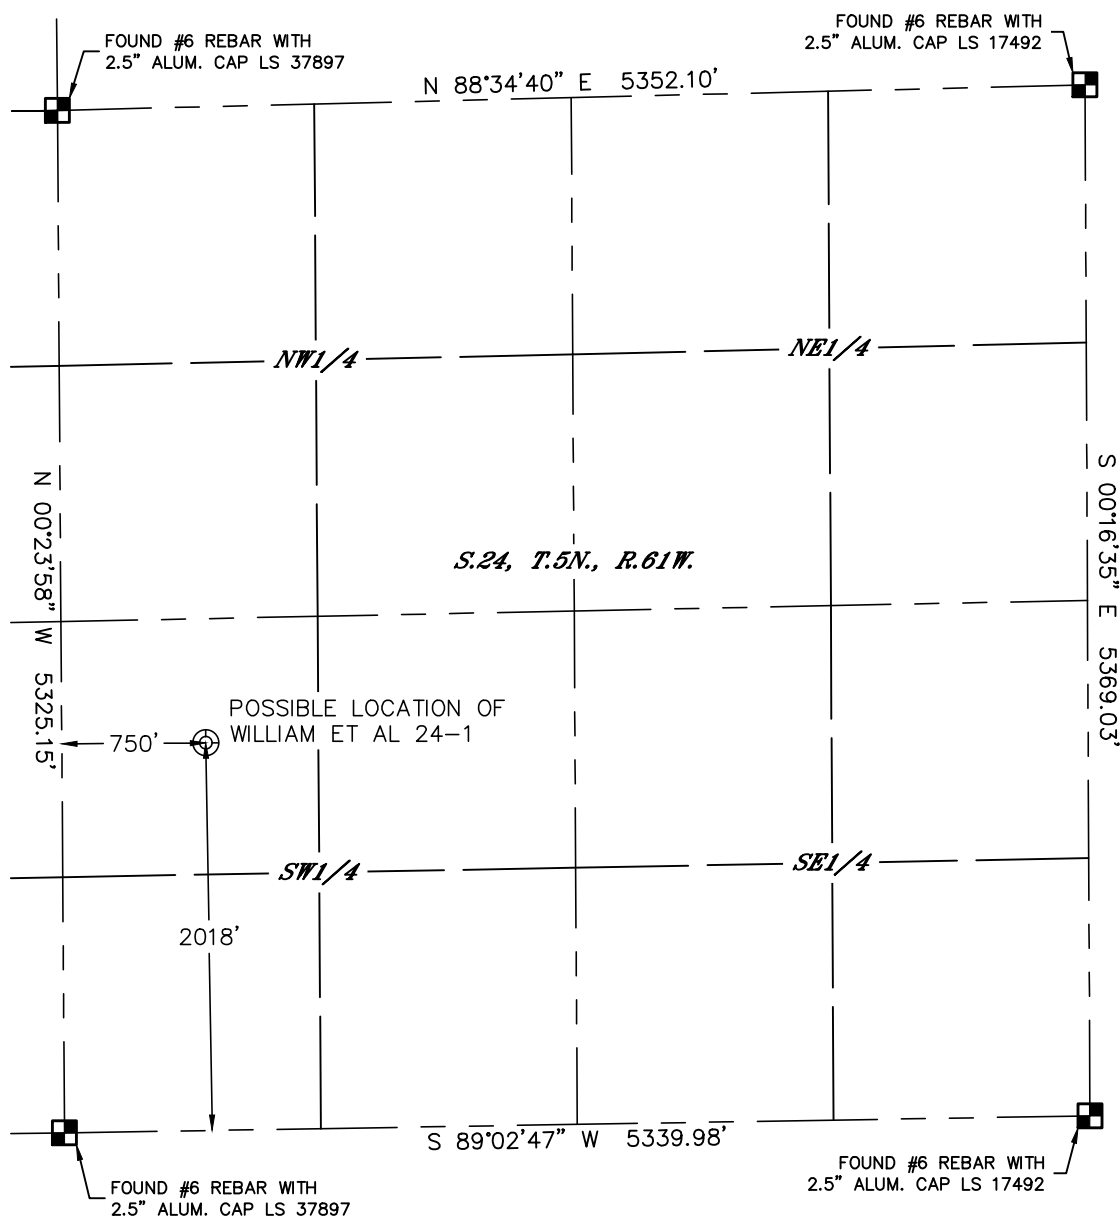

SURFACE LOCATION
LAT: 40.38493°N
LONG: 104.16353°W
PDOP: 2.3
ELEV: 4578'
1/4,1/4: NWSW

SURFACE DESCRIPTION
FOUND A METAL DETECTOR SIGNAL WITHIN 5' DIA. OF LOCATION. LARGE PIECES OF CONCRETE SCATTERED IN THE AREA. SET PINK LATH.

LEGEND

- = ALIQUOT MONUMENT AS DESCRIBED
- = CALCULATED POSITION

DATE: 7/14/2014
PROJECT#: 2013173



Lat40°, Inc. 1635 Foxtrail Drive, Suite 325 Loveland, CO 970-776-3321

P&A WELL LOCATION PICTURES

WILLIAMS ET AL 24-1

SECTION: 24
TOWNSHIP: 5N
RANGE: 61W

DATE: 7/14/2014



VIEW NORTH



VIEW WEST



VIEW EAST



VIEW SOUTH

DATE: 7/14/2014
PROJECT#: 2013173