


VOC unit 75' up  
road from tanks

2-2" surface flowlines  
between tanks and units  
(one water/one oil)

2 water tanks  
2 condensate tanks

2 quad separators  
1 double separator

10 - 2" steel flowlines  
buried 4" deep

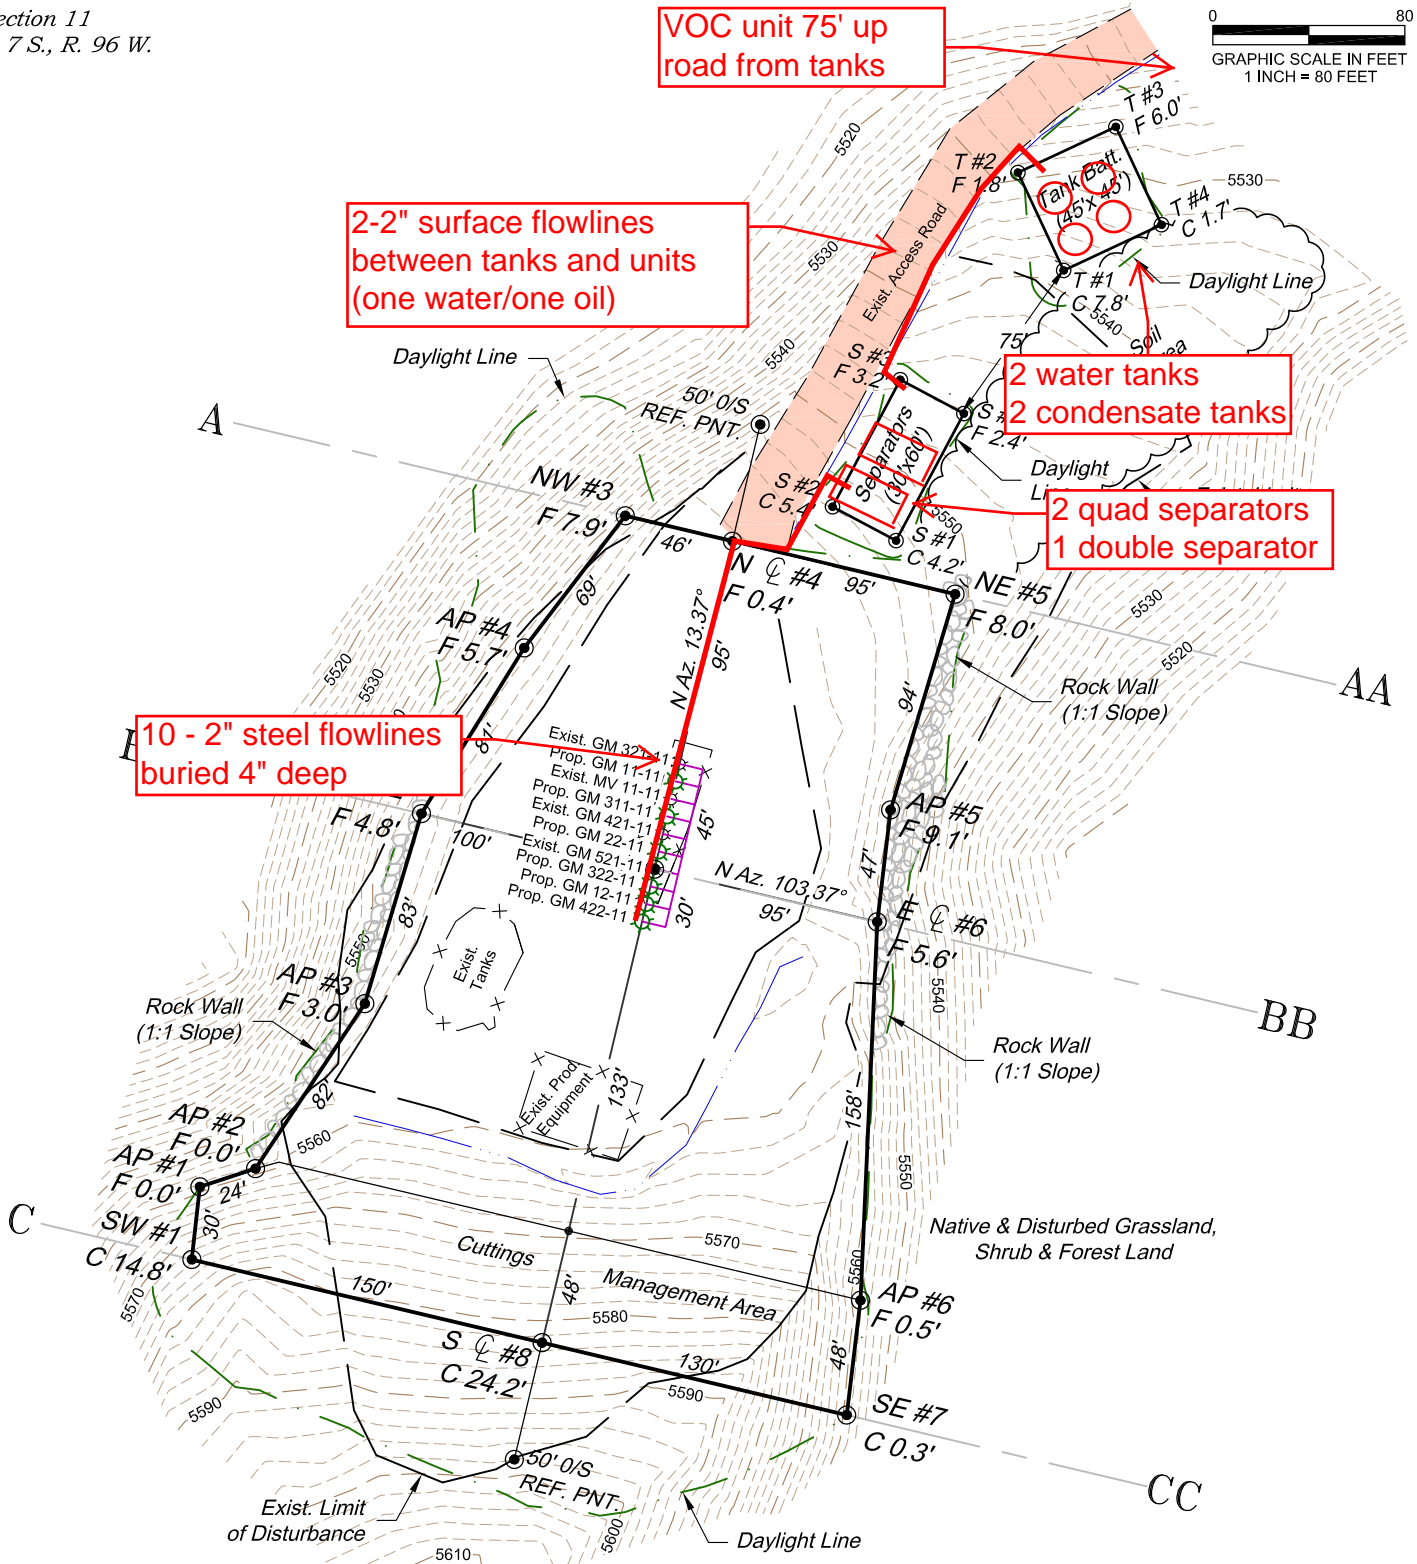

# ESTIMATED EARTHWORK QUANTITIES (cy)

ITEM	CUT	FILL	TOPSOIL	EXCESS
PAD	18970	3490	1200	14280
PIT	0			0
TOTALS	18970	3490	1200	14280

## \*NOTE:

- 1.) 10% Swell Factor Applied to Earthwork Cut Volume.
- 2.) Topsoil Volume Based on 12" Soil Depth.
- 3.) Total Disturbed Area = ±3.99 ac.

136 East Third Street  
Rifle, Colorado 81650  
Ph. (970) 625-2720  
Fax (970) 625-2773



**BOOKCLIFF**  
Survey Services, Inc.

SCALE: 1" = 80'  
DATE: 8/11/14  
PLAT: 2 of 7  
PROJECT: Valley  
DFT: cs

Construction Plan Prepared for:  
**WPXENERGY** WPX Energy Rocky Mountain, LLC

MV 11-11 Drill Pad - Plat 2  
**Facility Layout Drawing**