


Tepee Park Ranch Pad 25A

SPILL LOCATION 8/24/2014

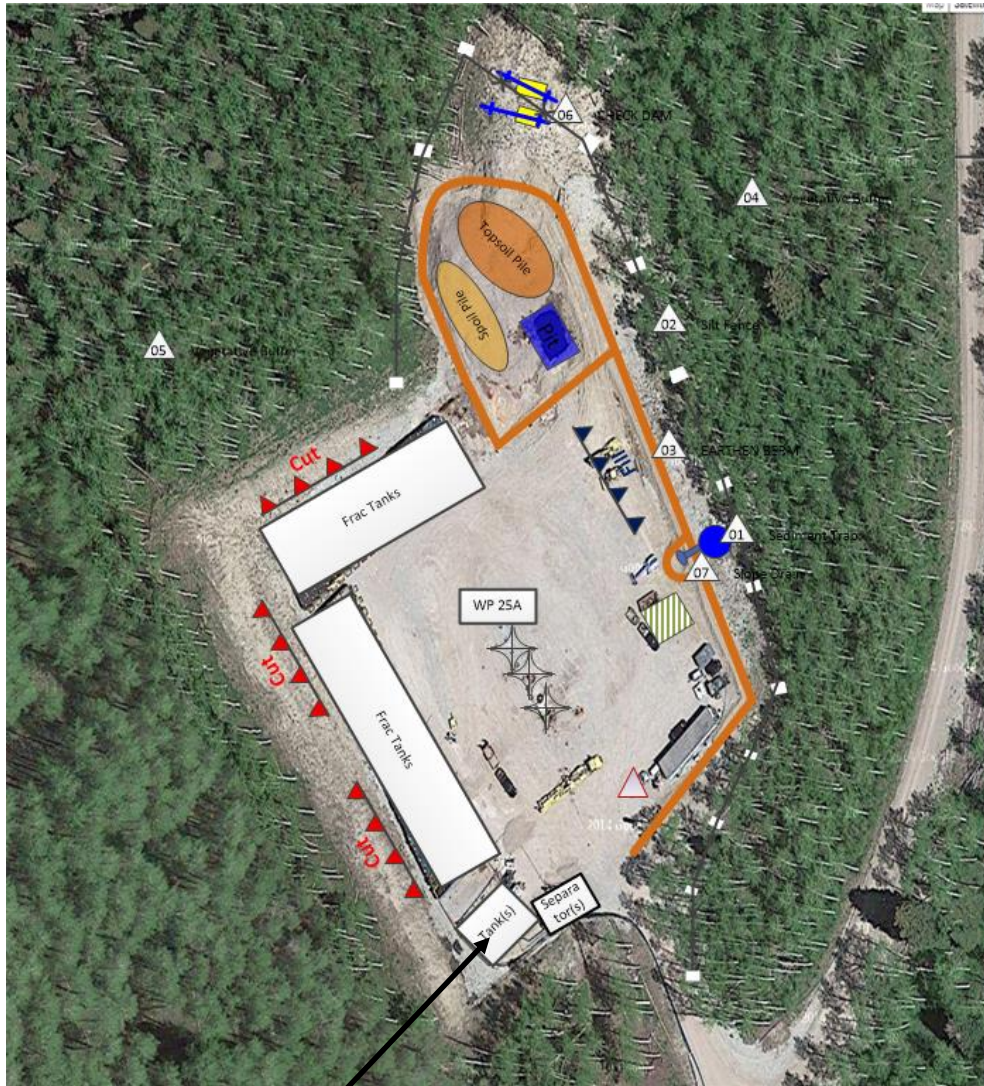

Site ID: WP-00001
 Site Name: 25A Pad
 Field: Tepee
 Phase: Interim Stabilization
 Map Date: 8/12/2014



- 01 Sediment Trap
- 02 Silt Fence
- 03 EARTHEN BERM
- 04 Vegetative Buffer
- 05 Vegetative Buffer
- 06 CHECK DAM
- 07 Slope Drain
- 08
- 09
- 10
- 11
- 12
- 13
- 14
- 15
- 16
- 17
- 18
- 19
- 20
- 21
- 22
- 23
- 24
- 25

APPROXIMATE SPILL LOCATION