


**WPX Energy Rocky Mountain LLC
SAVAGE RWF 43-25
RULISON Field**

**SHL 1192' FSL 1382' FEL (SW/4 SE/4) Section 25 T6S R94W 6th PM
BHL 2466' FSL 673' FEL (NE/4 SE/4) Section 25 T6S R94W 6th PM
Garfield County Colorado**

**Formation Tops
(Measured Depths)**

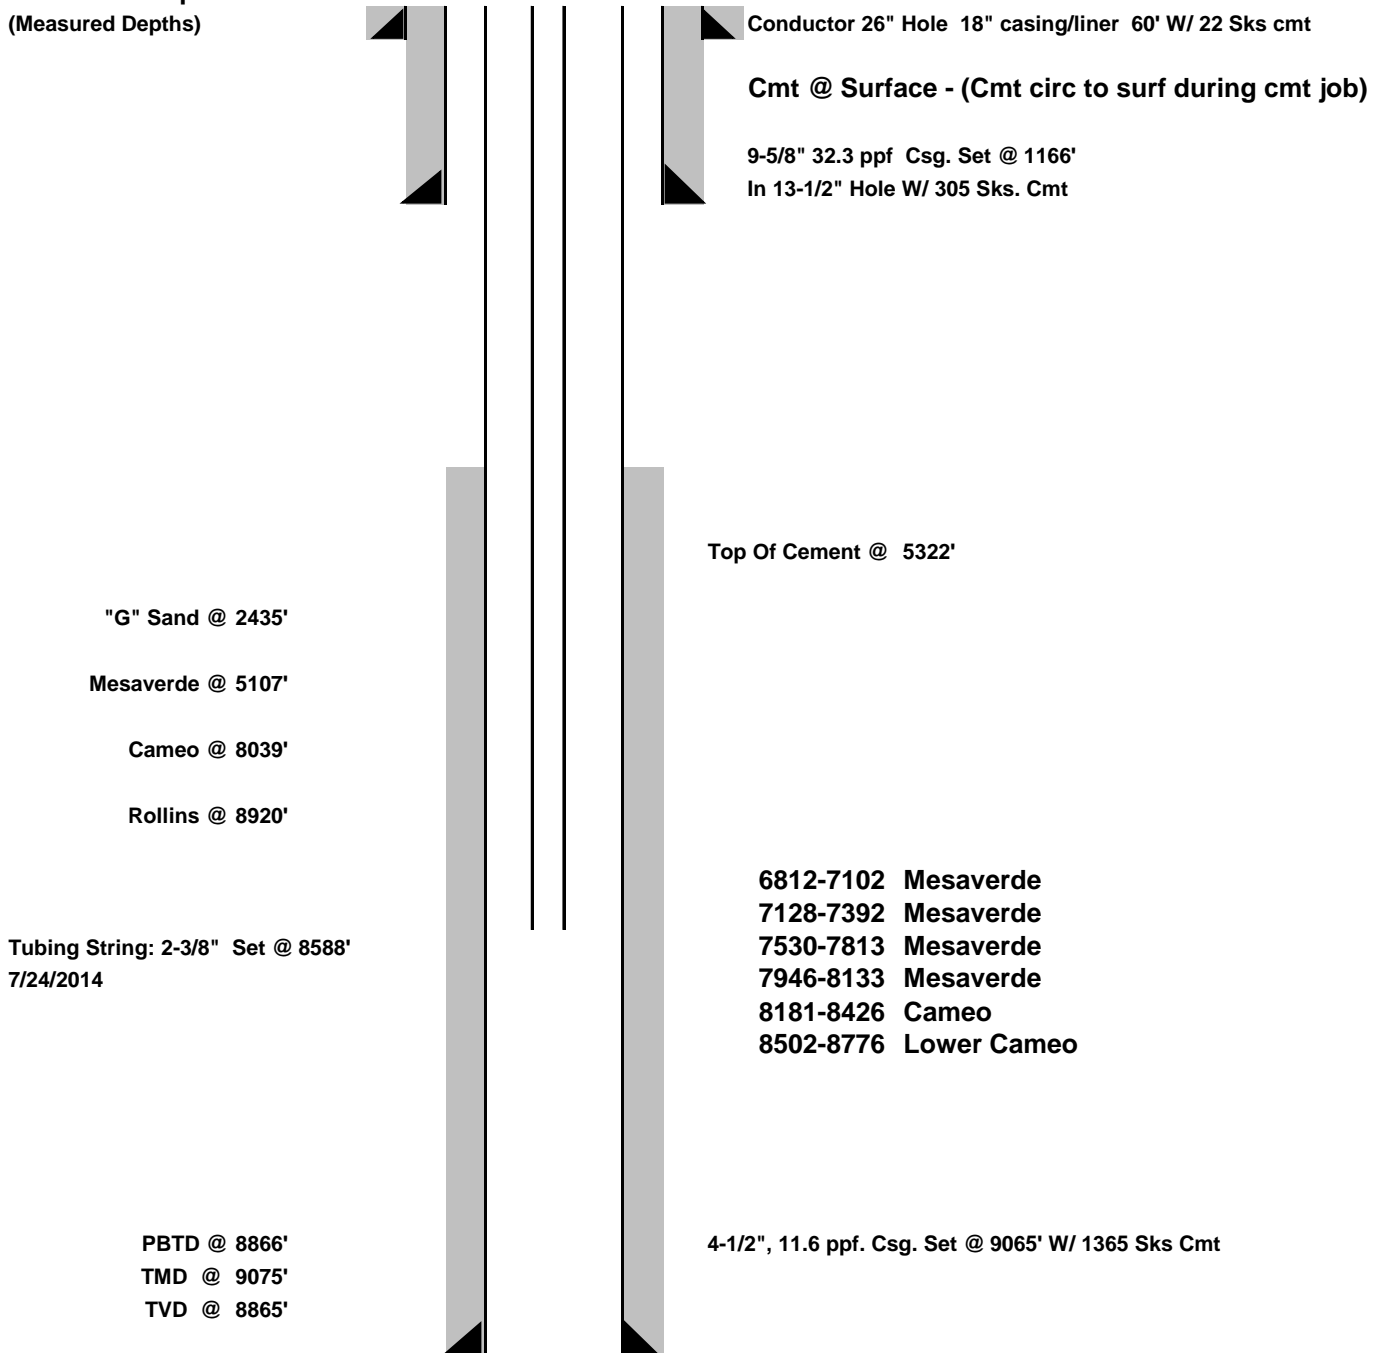

DATE CREATED: 8.06.14

NOTE: THIS IS NOT TO SCALE.
****FINAL****