




WELL LOCATION CERTIFICATE

THIS MAP DOES NOT REPRESENT A BOUNDARY SURVEY

SECTION: 34
TOWNSHIP: 6N
RANGE: 45W

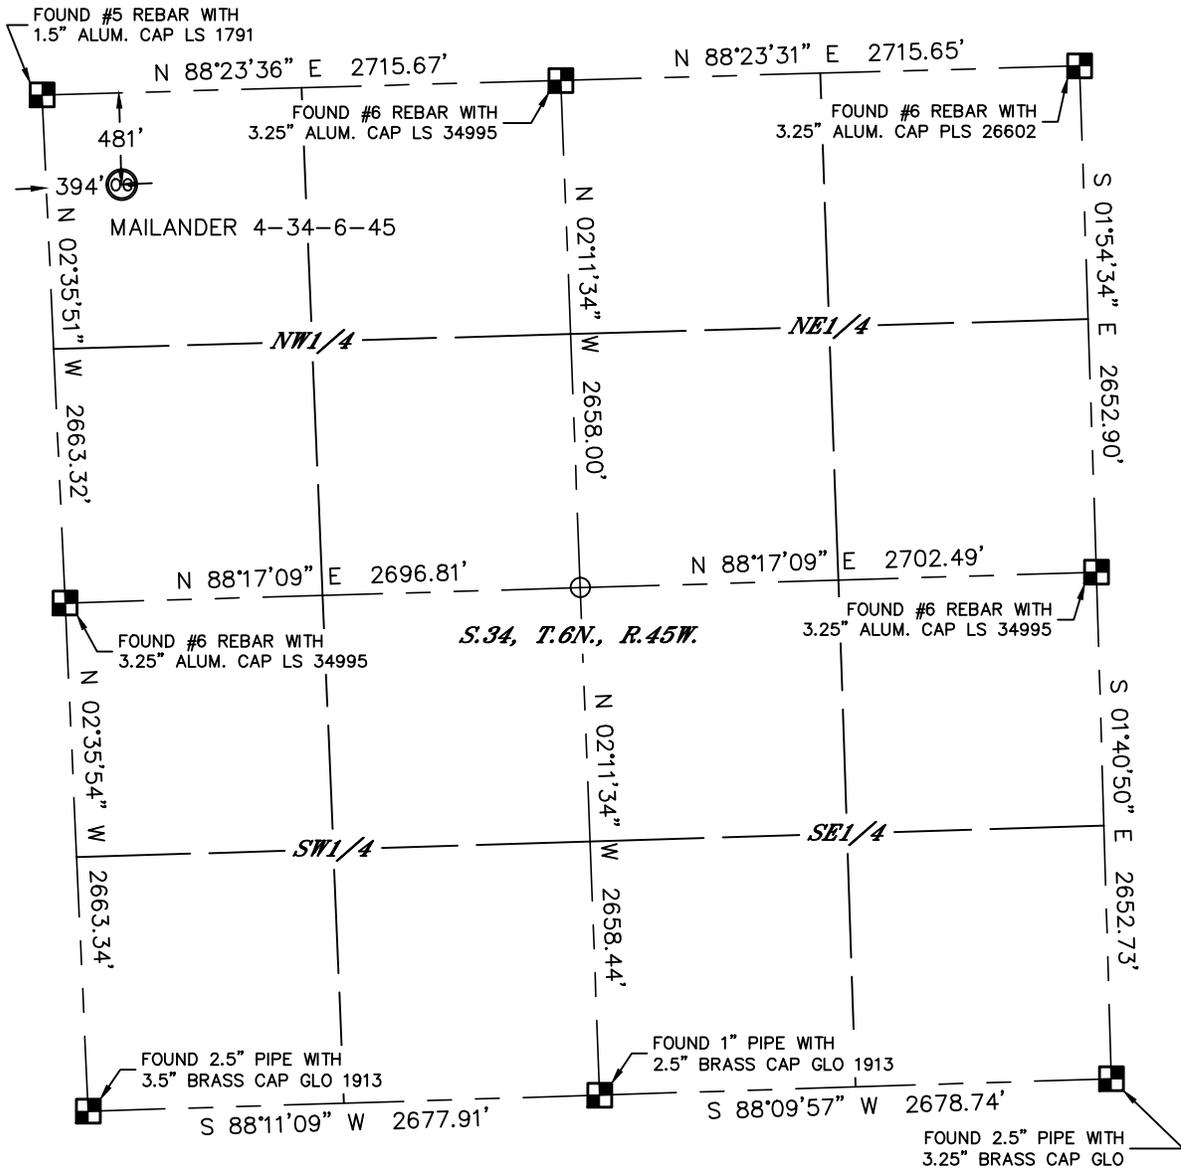

In accordance with a request from Michelle Lewis with OMIMEX PETROLEUM, INC. Lat40°, Inc. has determined the surface location of the MAILANDER 4-34-6-45 to be 481' from the NORTH line and 394' from the WEST line as measured at right angles from the section lines of Section 34, Township 6 North, Range 45 West of the Sixth Principal Meridian, County of Phillips, State of Colorado.

I hereby state that this Well Location Certificate was prepared by me, or under my direct supervision, that the fieldwork was completed on 8/14/2014, for and on behalf of OMIMEX PETROLEUM, INC. That this is not a Land Survey Plat or an Improvement Survey Plat, and that it is not to be relied upon for establishment of fence, building, or other future improvement lines.

- NOTE:
- 1) Bearings shown are Grid Bearings of the Colorado State Plane Coordinate System, North Zone, North American Datum 1983. The lineal dimensions as contained herein are based upon the "U.S. Survey Foot."
 - 2) Ground elevations are based on an observed GPS elevation (NAVD 1988 DATUM).
 - 3) IMPROVEMENTS: See LOCATION DRAWING for all visible improvements within 500' of disturbed area.
 - 4) SURFACE USE: RANGELAND
 - 5) INSTRUMENT OPERATOR: ADAM BEAUPREZ
 - 6) NEAREST CULTURAL ITEMS:
BUILDING: ±4627' SW
BUILDING UNIT: ±4909' SW
HIGH OCCUPANCY BUILDING UNIT: +5280'
DESIGNATED OUTSIDE ACTIVITY AREA: +5280'
PUBLIC ROAD: ±385' W (CR 31)
ABOVEGROUND UTILITY: ±4872' S
RAILROAD: +5280'
PROPERTY LINE: ±394' W

SURFACE LOCATION
LAT: 40.45294°N
LONG: 102.37690°W
PDOP: 2.4
ELEV: 3874'
1/4,1/4: NWNW



LEGEND

- = ALIQUOT MONUMENT AS DESCRIBED
- = CALCULATED POSITION

Kyle E. Rutz—On behalf of Lat40°, Inc.
Colorado Licensed Professional
Land Surveyor No. 38307
DATE: 8/25/2014
PROJECT#: 2014138