


KERR-MCGEE OIL AND GAS ONSHORE LP
VON FELDT 14-12
SE SW 12 2N 67W 600' FSL 2,100' FWL
WELD,COLORADO
08/22/2014

AREA: W1 **ROUTE: W14** **Spud: 03/18/2005** **WINS No.: 74413** **AFE/WO#: 88408735** **API#: 0512322717**

GL: 4840 **KB: 4856** **MTD: 7967** **TVD: 7967** **LOG MD: 7964** **PBMD: 7927** **PBTVD: 7927**

Directions: **RD. 23 & 22 1/2 : EAST 1/2 MI., SOUTH INTO.**

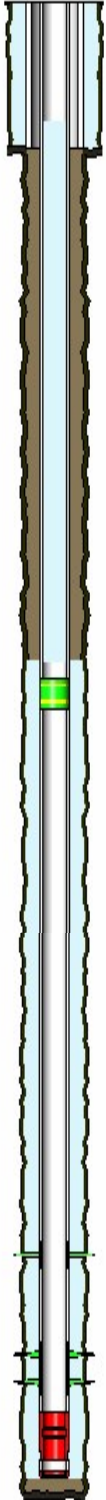

<u>HOLE SECTIONS</u>	<u>Size</u>	<u>Top</u>	<u>Btm</u>	<u>TD Date</u>
SURFACE	12.25	16	918	03/20/2005
PRODUCTION	7.88	919	7967	03/25/2005

<u>TUBULARS</u>	<u>Tool Type</u>	<u>Joints</u>	<u>Size</u>	<u>Weight</u>	<u>Grade</u>	<u>Thread</u>	<u>Top D</u>	<u>Bottom D</u>
SURFACE CASING	Casing	20	8.63	24	J-55	STC	16	907
PRODUCTION CASING	Casing	190	4.50	11.6	I-80	LTC	16	7926
	Casing Float Collar	1	4.50				7926	7927
	Casing	1	4.50				7927	7938
	Casing Guide Shoe	1	4.50				7938	7939
BRIDGE PLUG	Retrievable Bridge F	1	4.50				4122	4127

<u>CEMENT JOBS</u>	<u>Stage</u>	<u>Sacks</u>	<u>Cement Jobs</u>	<u>Top D</u>	<u>Btm D</u>	<u>cbl</u>
SURFACE CASING	STAGE 1	695	NEAT	16	907	No
PRODUCTION CASING	STAGE 1 LEAD	480	LITE	4016	6886	Yes
	STAGE 1 TAIL	280	50/50 POZ-MIX	6886	7942	Yes
PRODUCTION CASING	ABANDONMENT PLUC	775	LEAD FRESH WATER	730	4023	No

<u>PERFORATIONS</u>							
<u>Formation</u>	<u>Zone</u>	<u>Top</u>	<u>Btm</u>	<u>Date</u>	<u>Reason</u>	<u>Comments</u>	
CODELL		7366	7386	04/04/2005	PRODUCTION		
J SAND		7816	7820	01/30/2009	PRODUCTION		
J SAND		7828	7856	01/30/2009	PRODUCTION		

Comments: