




DRILLING COMPANY, INC.

WICHITA, KANSAS

PROPOSED WELLBORE CONFIGURATION

Date:	9/5/2014
Well Name:	APC-Charlotte #2-3
Location:	2390' FNL & 718' FEL Section 3-T16S-R45W
County:	Cheyenne
State:	Colorado
API:	05-061-06730-00
Spud Date:	7/2/1996
Hole Size:	12 1/4"
Surface Casing:	Set @ 451' (8 5/8")
Cemented with:	300 sx
Production Csg:	Set @ 4595' (4 1/2")
Cemented with:	150 sx EA-2
RTD:	5433'

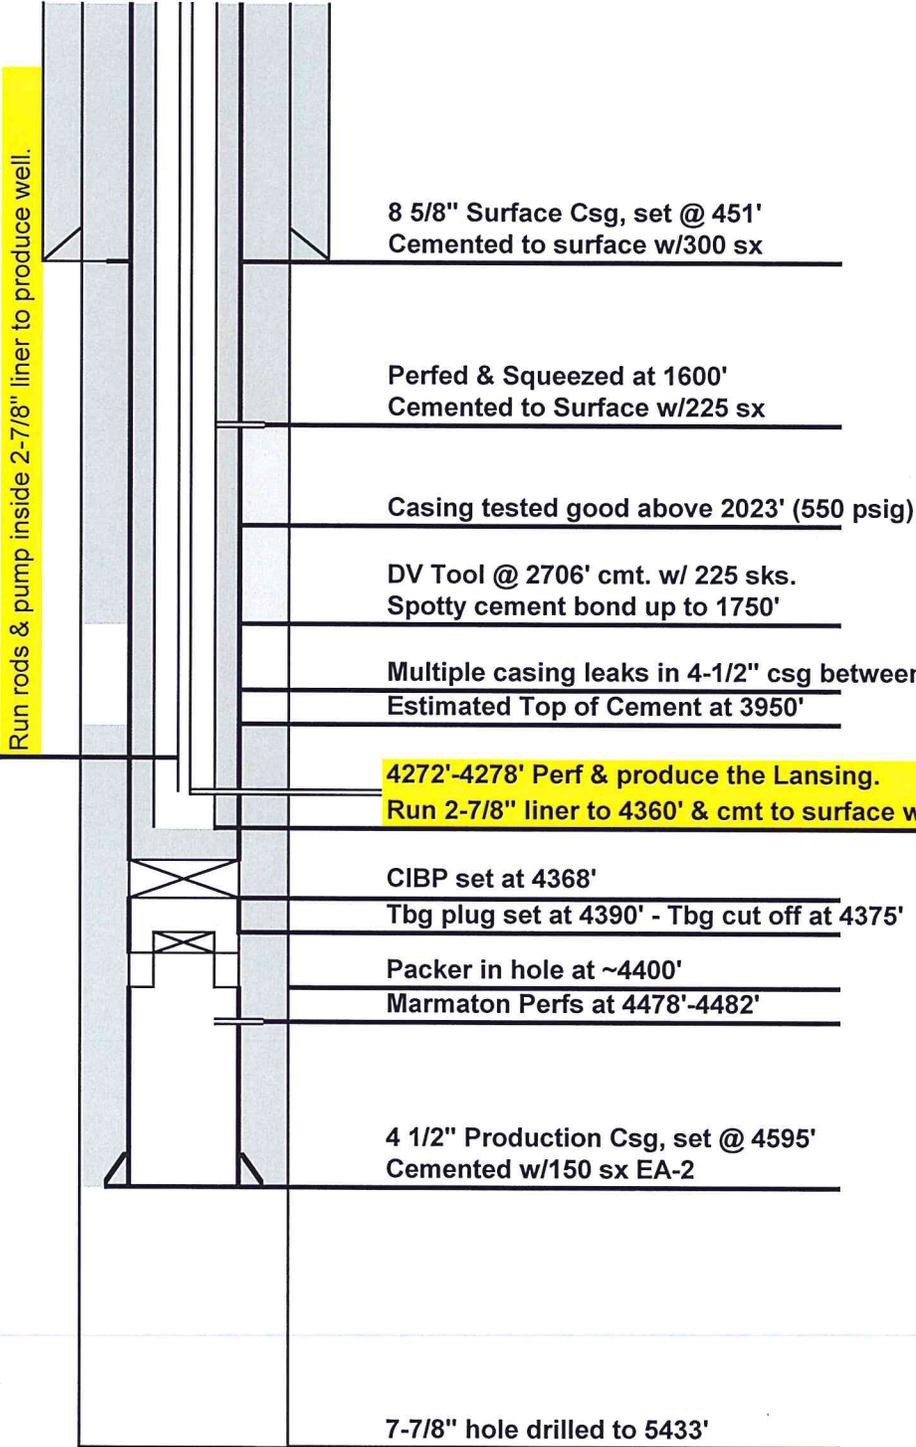

7-7/8" hole drilled to 5433'