



Physical Address: 345 Comanche St.
 Mail to: Box 384 Kiowa, CO 80117
 Ph. 303-621-8672 - Fax 303-621-7749
 www.highprairiesurvey.com

Job # 14164 MARY JANE #7-5

Inv # 3198

High Prairie Surveying of Kiowa, Colorado, in accordance with a request from **Nighthawk Production LLC**, has determined the location of **MARY JANE #7-5** to be **1870 feet FNL**, and **660 feet FEL** (90° off Section lines) of Section **5**, Township **7s**, Range **54w** of the 6th Principal Meridian, **Lincoln County**, Colorado.


Date: Staked on 05/23/14 drawn on 05/29/14.

Re: Staked by Elijah Frane
Drawn: Drawn by Dustin Cotter

Basis of Elevation Spot: USGS BM = TETLOW, PID = KJ0482, H-Order = Adjusted, V-Order = Sealed, Stability = Unknown, P-DOP = 2.6, Sats = 7 US NAD 83 CO-C 502, Lat. = 39.55762, Long. = W103.43345, Elevation = 5258.00 gr. (65.77')

Notes: See Location Drawing for improvements within 500' of the proposed well pad / head.
 The ground elevation at staked location = 5340.00' gr.
 This drawing does not represent a monumented survey or Land Survey Plat.

Basis of Bearing: Bearings were determined based on the North line of Section 5 to bear N87°48'42"E with all other bearings contained herein relative thereto.

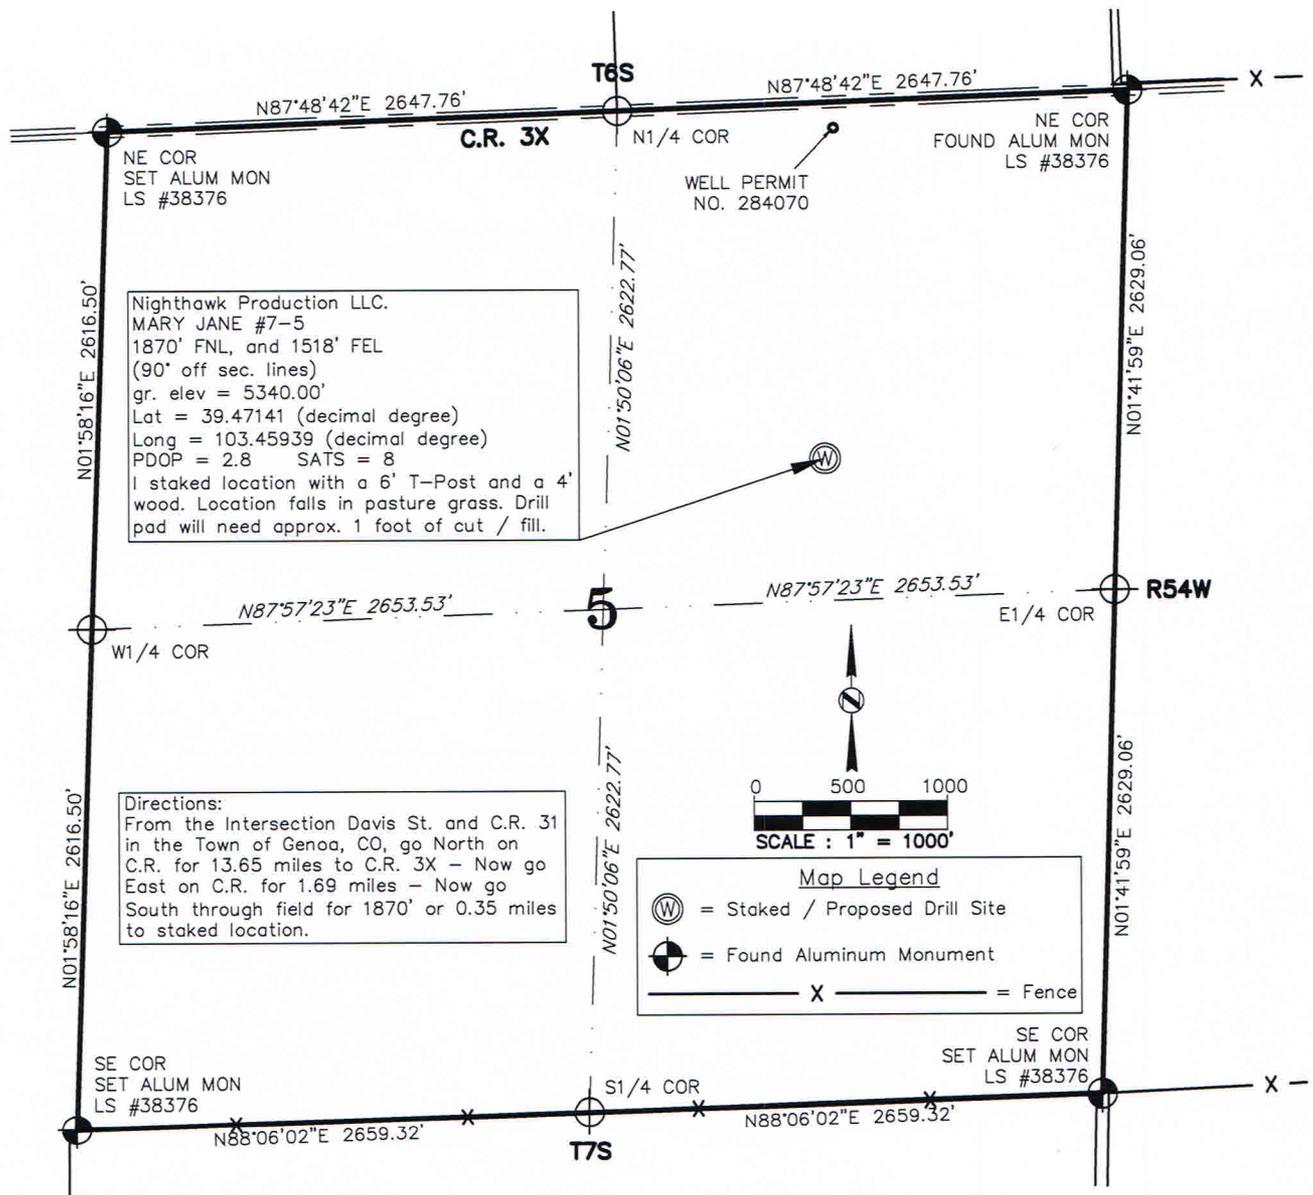

Nighthawk Production LLC.
 MARY JANE #7-5
 1870' FNL, and 1518' FEL
 (90° off sec. lines)
 gr. elev = 5340.00'
 Lat = 39.47141 (decimal degree)
 Long = 103.45939 (decimal degree)
 PDOP = 2.8 SATS = 8
 I staked location with a 6' T-Post and a 4'
 wood. Location falls in pasture grass. Drill
 pad will need approx. 1 foot of cut / fill.

Directions:
 From the Intersection Davis St. and C.R. 31
 in the Town of Genoa, CO, go North on
 C.R. for 13.65 miles to C.R. 3X - Now go
 East on C.R. for 1.69 miles - Now go
 South through field for 1870' or 0.35 miles
 to staked location.