


Before Replug Schematic:

10-3/4" 32.75# H40 Surface
Set @ 381' MD

10 sx cement @ top of surface csg


40 sx cement @ 362'-450'

8 3/4" OH
To 9393' MD

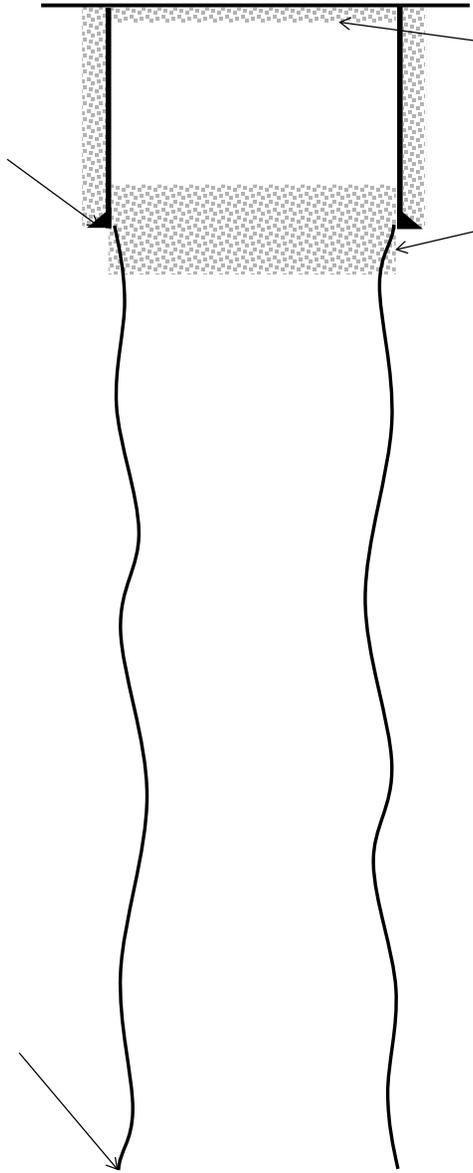

After Replug Schematic:

10-3/4" 32.75# H40 Surface
Set @ 381' MD

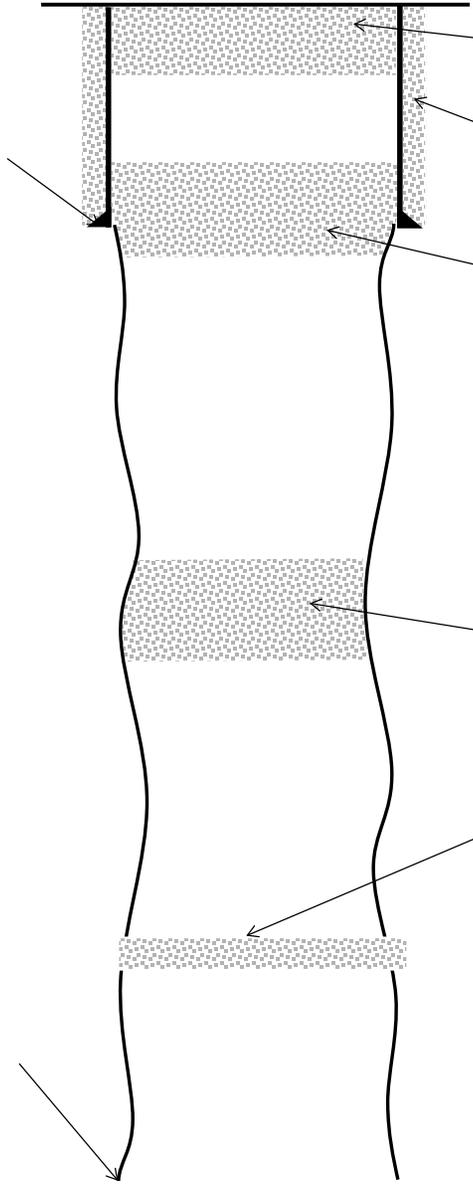

~95' cement @ top of surface csg

50 sx cement backside of surface casing

50 sx balanced plug from 331' to 431'

50 sx balanced plug from 2500' to 2344'

25 sx cement 6680'

8 3/4" OH
To 9393' MD