




# WELL LOCATION CERTIFICATE

SECTION: 19  
TOWNSHIP: 7N  
RANGE: 65W

THIS MAP DOES NOT REPRESENT A BOUNDARY SURVEY

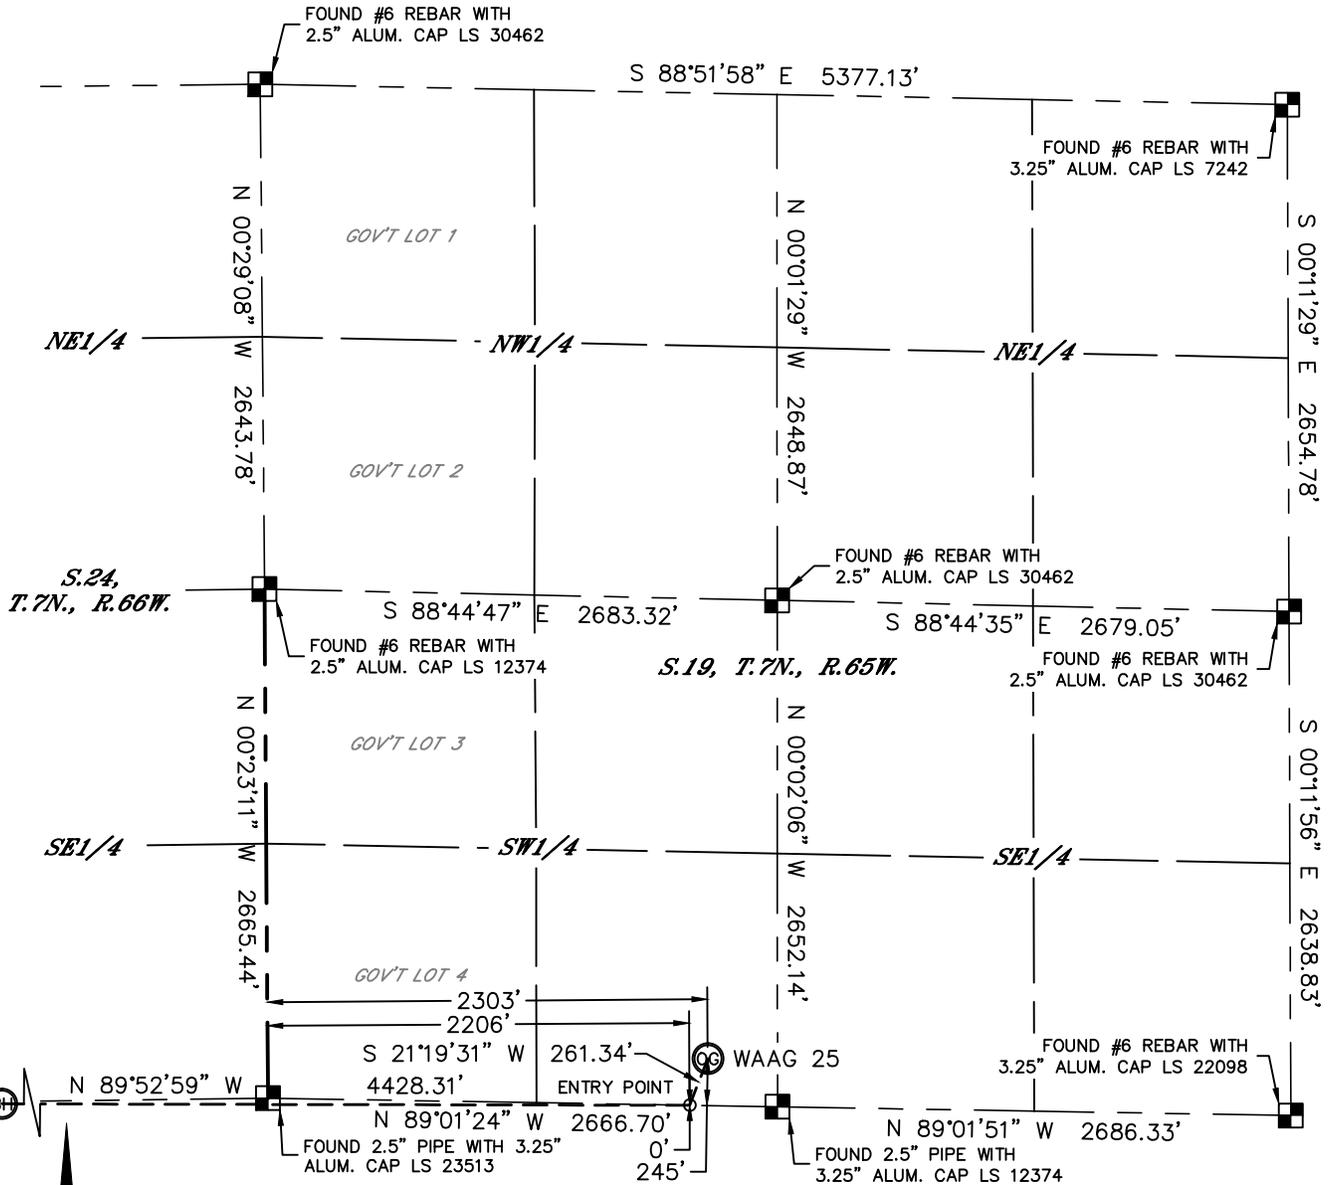

In accordance with a request from Derek Petrie with EXTRACTION OIL & GAS Lat40°, Inc. has determined the surface location of the WAAG 25 to be 245' from the SOUTH line and 2303' from the WEST line of Section 19, Township 7 North, Range 65 West and the bottom hole to be 0' from the SOUTH line and 2222' from the EAST line as measured at right angles from the section lines of Section 24, Township 7 North, Range 66 West of the Sixth Principal Meridian, County of Weld, State of Colorado.

I hereby state that this Well Location Certificate was prepared by me, or under my direct supervision, that the fieldwork was completed on 7/2/2014, for and on behalf of EXTRACTION OIL & GAS That this is not a Land Survey Plat or an Improvement Survey Plat, and that it is not to be relied upon for establishment of fence, building, or other future improvement lines.



**NOTE:**

- 1) Bearings shown are Grid Bearings of the Colorado State Plane Coordinate System, North Zone, North American Datum 1983/2007. The lineal dimensions as contained herein are based upon the "U.S. Survey Foot."
- 2) Ground elevations are based on an observed GPS elevation (NAVD 1988 DATUM).
- 3) IMPROVEMENTS: See LOCATION DRAWING for all visible improvements within 500' of disturbed area.
- 4) SURFACE USE: CROP LAND
- 5) INSTRUMENT OPERATOR: ADAM KELLY
- 6) NEAREST CULTURAL ITEMS:  
BUILDING: 1862' SE  
BUILDING UNIT: 1862' SE  
HIGH OCCUPANCY BUILDING UNIT: 5280'+  
DESIGNATED OUTSIDE ACTIVITY AREA: 5280'+  
PUBLIC ROAD: 235' S (CR 78)  
ABOVEGROUND UTILITY: 1333' SW  
RAILROAD: ±3632' SW  
PROPERTY LINE: 245' S

**SURFACE LOCATION**

LAT: 40.55415°N  
LONG: 104.70758°W  
PDOP: 1.8  
ELEV: 4867'  
1/4,1/4: SESW

**BOTTOM HOLE**

LAT: 40.55362°N  
LONG: 104.72386°W

**ENTRY POINT**

LAT: 40.55349°N  
LONG: 104.70793°W


**LEGEND**

- = ALIQUOT MONUMENT AS DESCRIBED
- = CALCULATED POSITION

**SHEET 1 OF 2**

Kyle E. Rutz—On behalf of Lat40°, Inc.  
Colorado Licensed Professional  
Land Surveyor No. 38307

DATE: rev7/15/2014  
PROJECT#: 2014064


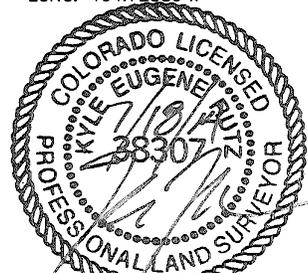




# WELL LOCATION CERTIFICATE

SECTION: 19  
TOWNSHIP: 7N  
RANGE: 65W


THIS MAP DOES NOT REPRESENT A BOUNDARY SURVEY

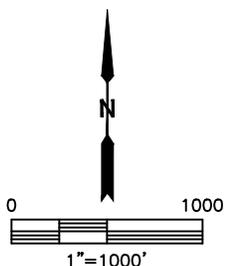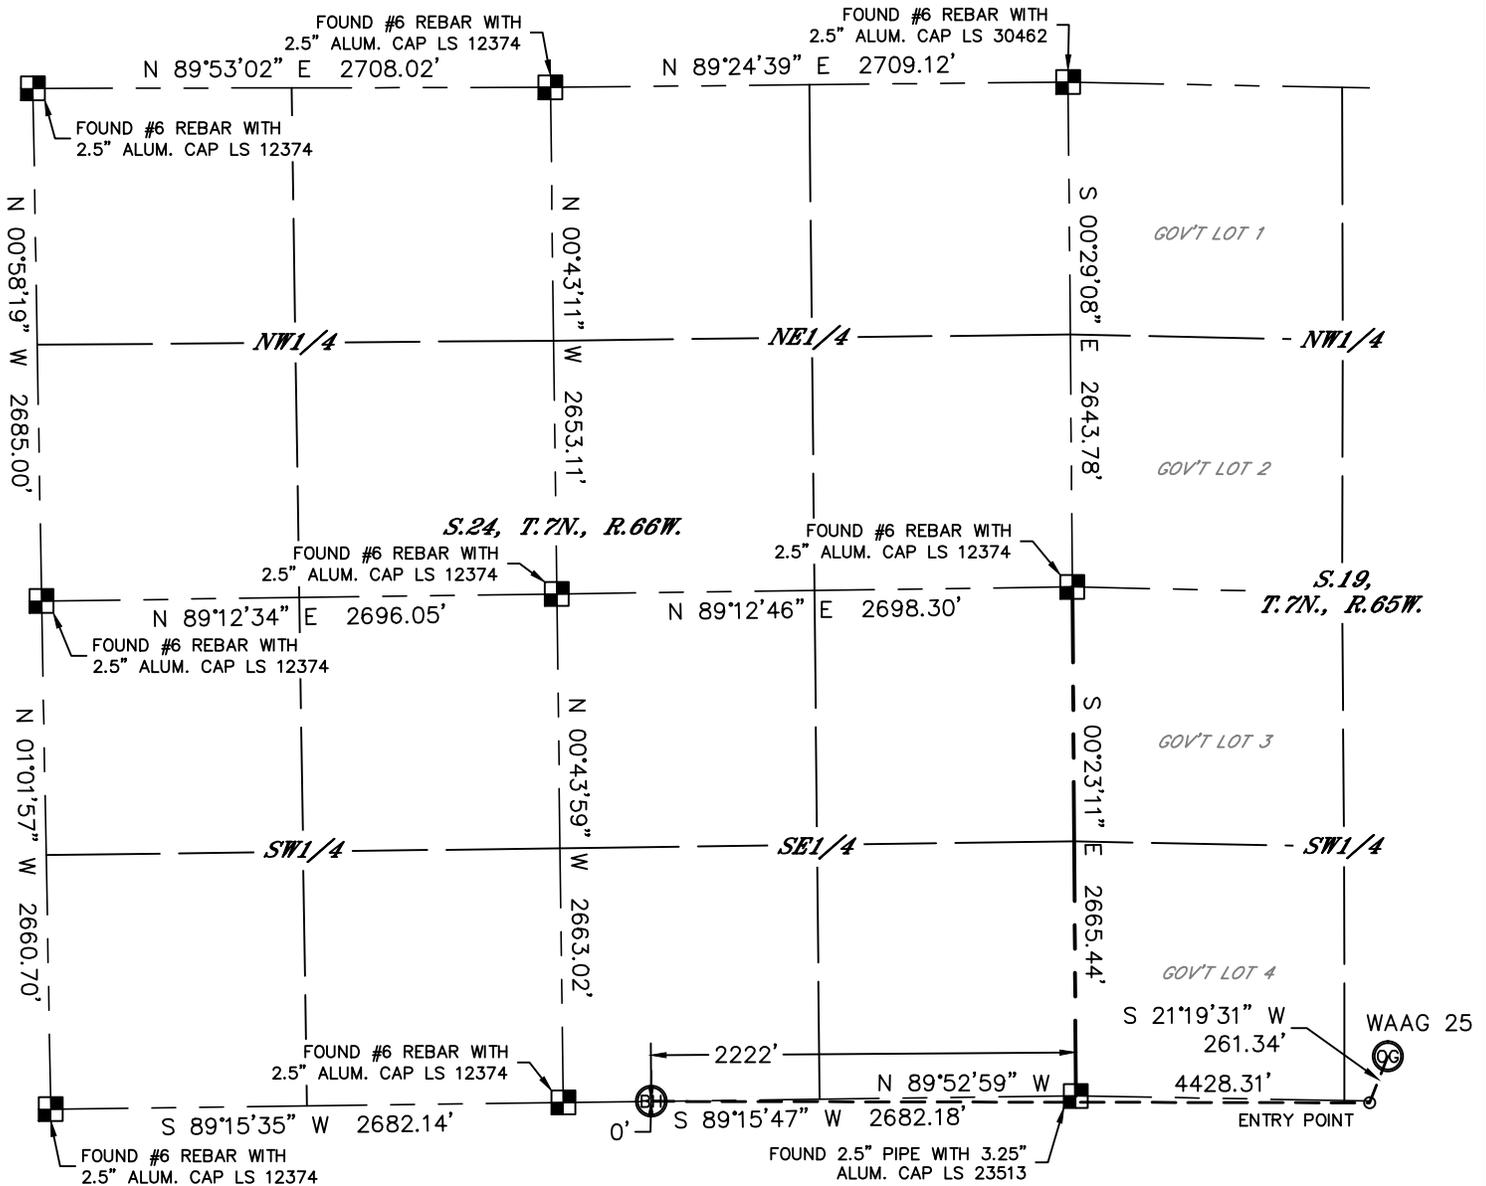

### LEGEND

- = ALIQUOT MONUMENT AS DESCRIBED
- = CALCULATED POSITION

**SHEET 2 OF 2**

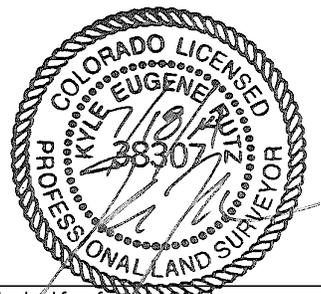

Kyle E. Rutz—On behalf of Lat40°, Inc.  
 Colorado Licensed Professional  
 Land Surveyor No. 38307


DATE: rev7/15/2014  
 PROJECT#: 2014064



# SITE SKETCH

WAAG 25

SECTION: 19  
TOWNSHIP: 7N  
RANGE: 65W

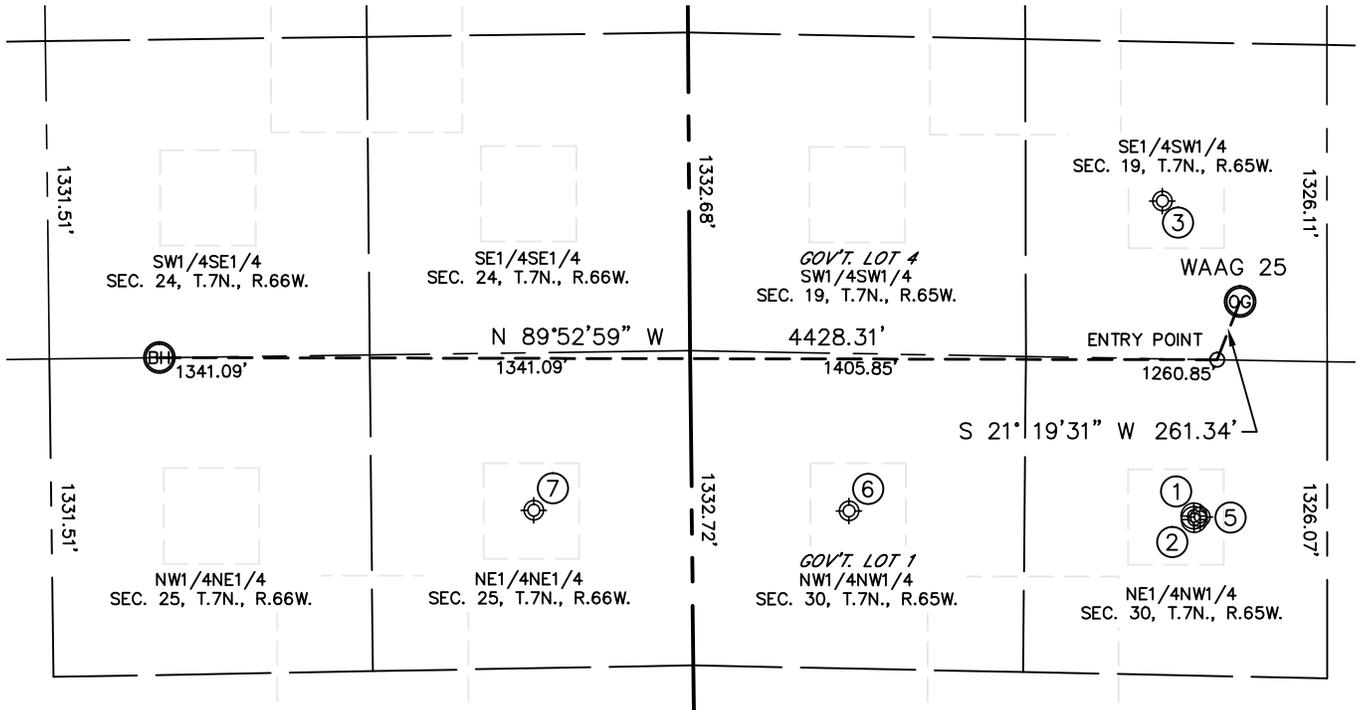

WELL NO.	WELL NAME	SHL FOOTAGE				SHL LAT°	SHL LONG°	PDOP	ELEV (FT.)	1/4/1/4
		657	FNL	2102	FWL					
1	GODBY 2-30	657	FNL	2102	FWL	40.55169	-104.70830	2.3	4866	NENW
2	GODBY 6-30	670	FNL	2102	FWL	40.55165	-104.70830	2.3	4867	NENW
3	FARR FARMS 1 (PA)	660	FSL	1980	FWL	40.55534	-104.70871	N/A	4863	SESW
5	MILE HIGH SHEEP 2 (PA)	660	FNL	2130	FWL	40.55159	-104.70815	N/A	4863	NENW
6	MILE HIGH SHEEP 12-30 (PA)	660	FNL	660	FWL	40.55168	-104.71343	N/A	4860	NWNW
7	ANDERSON 1-25 (PA)	660	FNL	660	FEL	40.55172	-104.71819	N/A	4856	NENE

NOTE: THE ABANDONED WELL DATA SHOWN IN RED ABOVE WAS OBTAINED FROM COGCC SCOUT CARDS.

