

KERR-MCGEE OIL AND GAS ONSHORE LP

UPRR 41 PAN AM H 1

NE SE 23 3N 68W 1,345' FSL 1,305' FEL

WELD,COLORADO

09/03/2014

AREA: W2

ROUTE: W22 Spud: 12/04/1989

WINS No.: 74291

AFE/WO#: 88592052

API#: 0512314386

GL: 4975

KB: 4988

MTD: 7985

TVD: 7985


LOG MD:

PBMD: 7891

PBTVD: 7891

Directions:

HWY 66 & CR 9 1/2, N 2/10, E 2/10 INTO. CORN, WATER PIPE, MAIN LEASE ROAD TO HZ PAD, OLD WELL HEAD PARTS

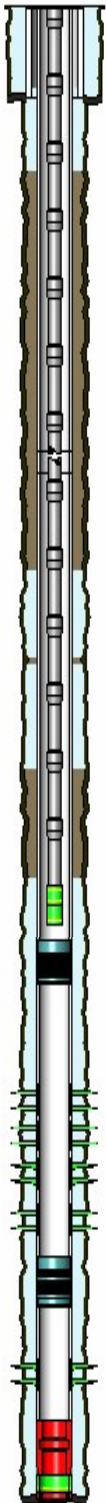

<u>HOLE SECTIONS</u>		<u>Size</u>	<u>Top</u>	<u>Btm</u>	<u>TD Date</u>				
SURFACE		12.25	13	680	12/04/1989				
PRODUCTION		7.88	680	7985	12/10/1989				
<u>TUBULARS</u>	<u>Tool Type</u>	<u>Joints</u>	<u>Size</u>	<u>Weight</u>	<u>Grade</u>	<u>Thread</u>	<u>Top D</u>	<u>Bottom D</u>	
SURFACE CASING		Casing	15	8.63	24	J-55	STC	13	667
PRODUCTION CASING		Casing	72	5.50	17.00	N-80	BT&C	13	3254
		Crossover	1	5.50		N-80		3254	3299
		Casing	109	5.50	17.00	N-80	LT&C	3299	7934
		Float Collar	1	5.50				7934	7936
		Shoe Joint	1	5.50	17.00	N-80	LT&C	7936	7979
		Casing Shoe	1	5.50				7979	7980
BRIDGE PLUG		Bridge Plug	1	5.50				7490	7493
BRIDGE PLUG		Bridge Plug	1	5.50				6355	6357
PRODUCTION TUBING		Tubing	200	2.38	4.70	J-55	External-Ups	10	6297
		XN Profile Nipple	1					6297	6298
		Retrieving Head	1					6298	6300
<u>CEMENT JOBS</u>	<u>Stage</u>	<u>Sacks</u>	<u>Cement Jobs</u>			<u>Top D</u>	<u>Btm D</u>	<u>cbl</u>	
SURFACE CASING		STAGE 1	225	LEAD	WRC LITE	13	400	No	
		STAGE 1	100	TAIL	REGULAR	400	667	No	
PRODUCTION CASING		STAGE 1	400		G	6240	7980	Yes	
PRODUCTION CASING		REMEDIAL CEMENT	270	LEAD	FRESH WATER	4676	5375	No	
PRODUCTION CASING		REMEDIAL CEMENT	120	LEAD	FRESH WATER	4000	4610	No	
PRODUCTION CASING		REMEDIAL CEMENT	130	LEAD	FRESH WATER	600	1200	No	
PRODUCTION CASING		SQUEEZE JOB	35	LEAD	FRESH WATER	5123	5450	No	
PRODUCTION CASING		SQUEEZE JOB				4510	4640	No	
PRODUCTION CASING		REMEDIAL CEMENT	15	LEAD	FRESH WATER	1380	1230	No	
<u>PERFORATIONS</u>									
<u>Formation</u>	<u>Zone</u>	<u>Top</u>	<u>Btm</u>	<u>Date</u>	<u>Reason</u>	<u>Comments</u>			
		1200	1201	05/23/2014	CEMENT SQUEEZE				
		4610	4611	05/27/2014	CEMENT SQUEEZE				
		5375	5376	05/22/2014	CEMENT SQUEEZE				
NIOBRARA	A	7092	7098	03/01/2012	PRODUCTION				
NIOBRARA	B	7132	7136	03/01/2012	PRODUCTION				
NIOBRARA	C	7188	7202	03/01/2012	PRODUCTION				
CODELL		7324	7344	03/01/2012	PRODUCTION				
J SAND		7766	7810	05/24/1990	PRODUCTION	VANN GUN SYSTEM			

KERR-MCGEE OIL AND GAS ONSHORE LP

UPRR 41 PAN AM H 1

NE SE 23 3N 68W 1,345' FSL 1,305' FEL

WELD,COLORADO

09/03/2014

AREA: W2

ROUTE: W22 Spud: 12/04/1989

WINS No.: 74291

AFE/WO#: 88592052

API#: 0512314386

GL: 4975

KB: 4988

MTD: 7985

TVD: 7985

LOG MD:

PBMD: 7891

PBTVD: 7891

Directions:

HWY 66 & CR 9 1/2, N 2/10, E 2/10 INTO. CORN, WATER PIPE, MAIN LEASE ROAD TO HZ PAD, OLD
WELL HEAD PARTS

Comments: