


WELL LOCATION CERTIFICATE

THIS MAP DOES NOT REPRESENT A BOUNDARY SURVEY

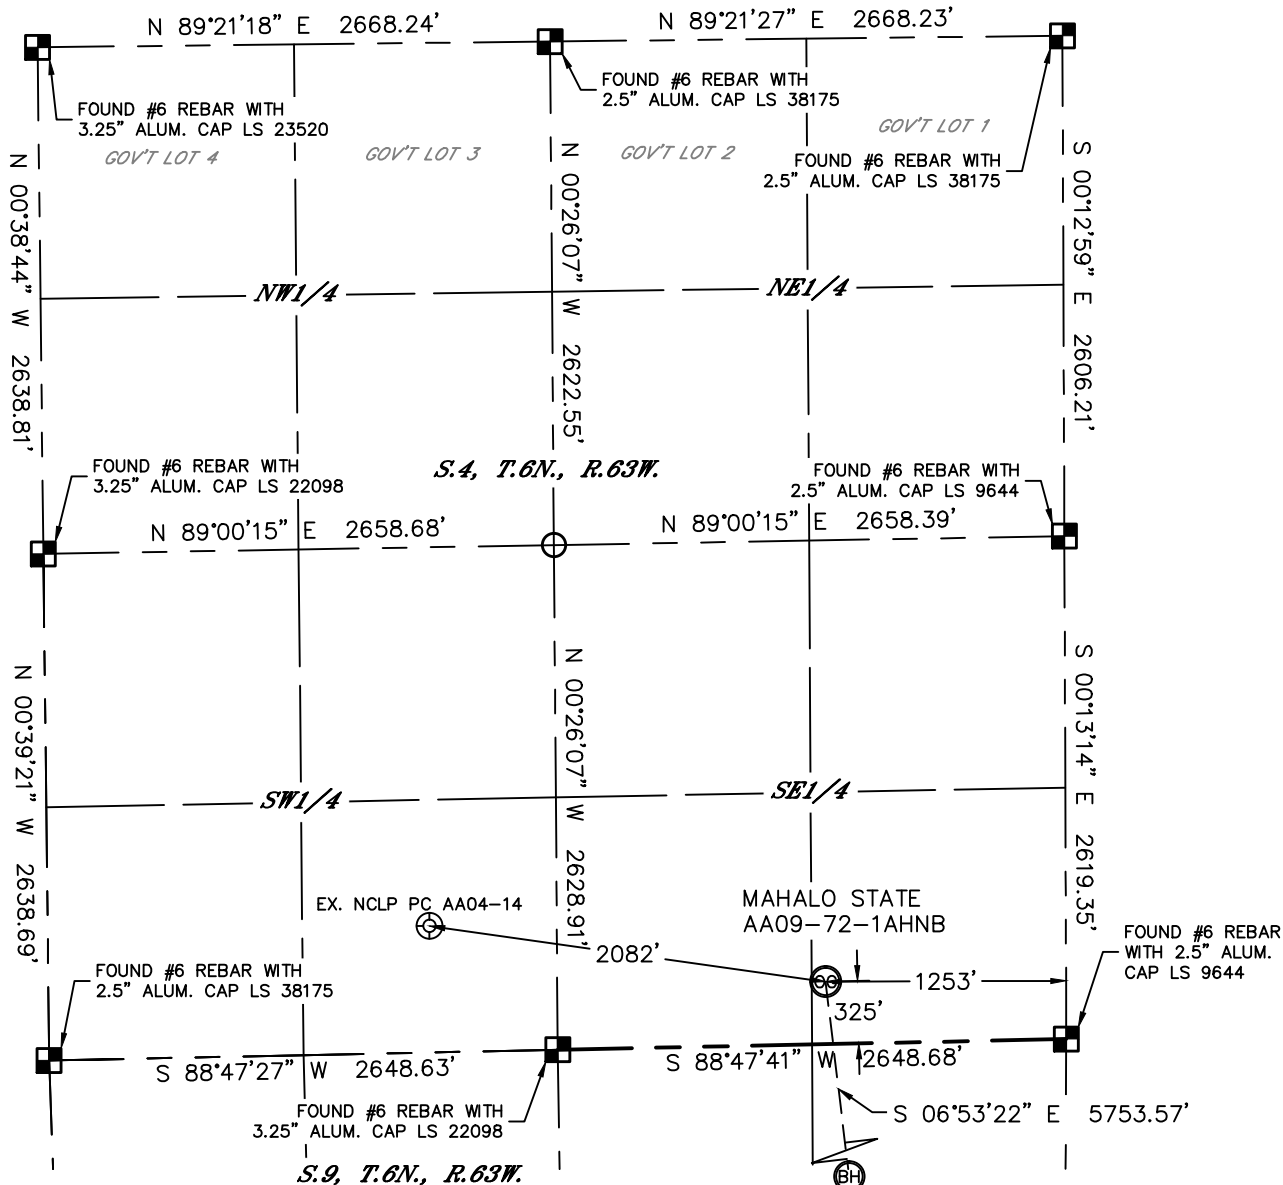

SECTION: 4
TOWNSHIP: 6N
RANGE: 63W



In accordance with a request from Cody Ball with Noble Energy Inc. Lat40th, Inc. has determined the surface location of the MAHALO STATE AA09-72-1AHNB to be 325' from the SOUTH line and 1253' from the EAST line as measured at right angles from the section lines of Section 4, Township 6 North, Range 63 West and the bottom hole to be 30' from the NORTH line and 535' from the EAST line as measured at right angles from the section lines of Section 16, Township 6 North, Range 63 West of the Sixth Principal Meridian, County of Weld, State of Colorado.


I hereby state that this Well Location Certificate was prepared by me, or under my direct supervision, that the fieldwork was completed on 8/9/2013, for and on behalf of Noble Energy Inc.. That this is not a Land Survey Plat or an Improvement Survey Plat, and that it is not to be relied upon for establishment of fence, building, or other future improvement lines.

NOTE:

- 1) Bearings shown are Grid Bearings of the Colorado State Plane Coordinate System, North Zone, North American Datum 1983/2007. The lineal dimensions as contained herein are based upon the "U.S. Survey Foot."
- 2) Ground elevations are based on an observed GPS elevation (NAVD 1988 DATUM).
- 3) IMPROVEMENTS: See LOCATION DRAWING for all visible improvements within 500' of disturbed area.
- 4) SURFACE USE: RANGELAND
- 5) INSTRUMENT OPERATOR: BRIAN ROTTINGHAUS
- 6) NEAREST EXISTING WELL: NCLP PC AA04-14, 2082'
- NEAREST CULTURAL ITEMS:
- BUILDING: $\pm 2492'$ SE
- BUILDING UNIT: $\pm 2492'$ SE
- HIGH OCCUPANCY BUILDING UNIT: 5280'+
- DESIGNATED OUTSIDE ACTIVITY AREA: 5280'+
- PUBLIC ROAD: 843' SE
- ABOVE GROUND UTILITY: 785' SE
- RAILROAD: 5280'+
- PROPERTY LINE: 325' S
- LEGEND
-  = ALIQUOT MONUMENT AS DE
-  = CALCULATED POSITION

SURFACE LOCATION
LAT: 40.50951°N
LONG: 104.43667°W
PDOP: 1.5
ELEV: 4700'
1/4,1/4: SE1/4SE1/4

BOTTOM HOLE
LAT: 40.49382°N
LONG: 104.43444°W

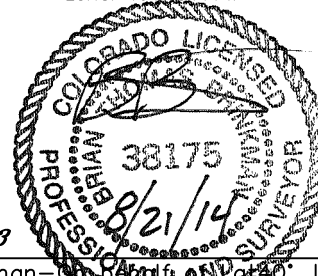

SHEET 1 OF 3

Colorado Licensed Professional Land Surveyor No. 38175
DATE: 8/20/2014
PROJECT#: 2013042





Lat40°, Inc. 1635 Foxtrail Drive, Suite 325 Loveland, CO 970-776-3321

WELL LOCATION CERTIFICATE

THIS MAP DOES NOT REPRESENT A BOUNDARY SURVEY

SECTION: 4
TOWNSHIP: 6N
RANGE: 63W

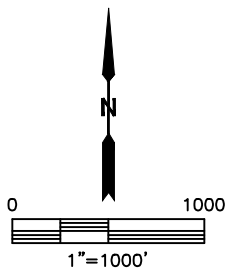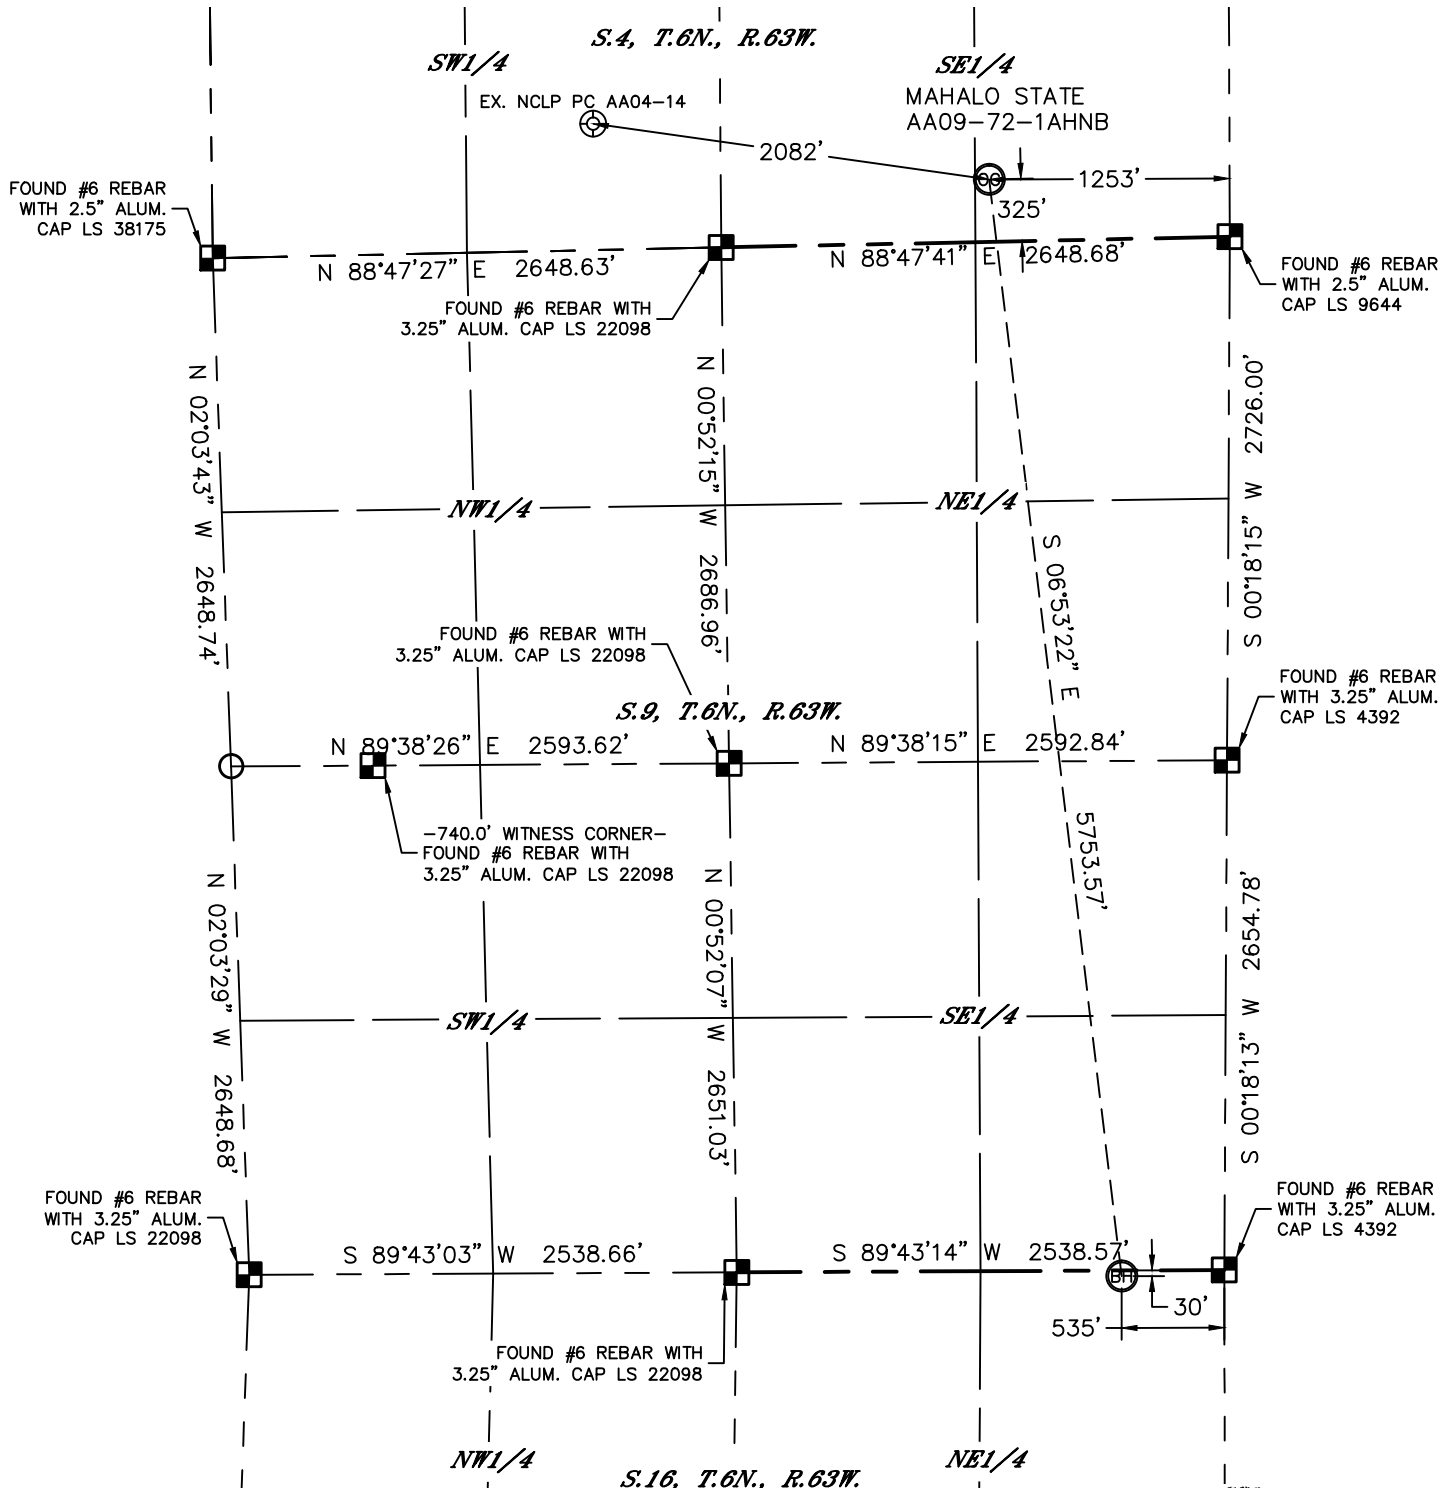


LEGEND

- = ALIQUOT MONUMENT AS DESCRIBED
- = CALCULATED POSITION

SHEET 2 OF 3

Brian T. Brinkman—Colorado Licensed Professional Land Surveyor No. 38175
DATE: 8/20/2014
PROJECT#: 2013042

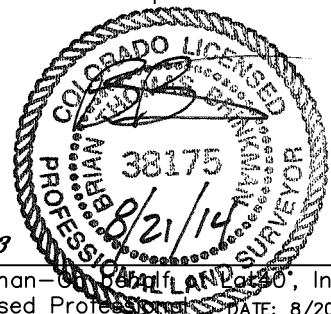





Lat40°, Inc. 1635 Foxtrail Drive, Suite 325 Loveland, CO 970-776-3321

WELL LOCATION CERTIFICATE

THIS MAP DOES NOT REPRESENT A BOUNDARY SURVEY

SECTION: 4
TOWNSHIP: 6N
RANGE: 63W

MAHALO STATE AA09-72-1AHNB

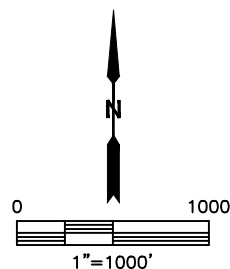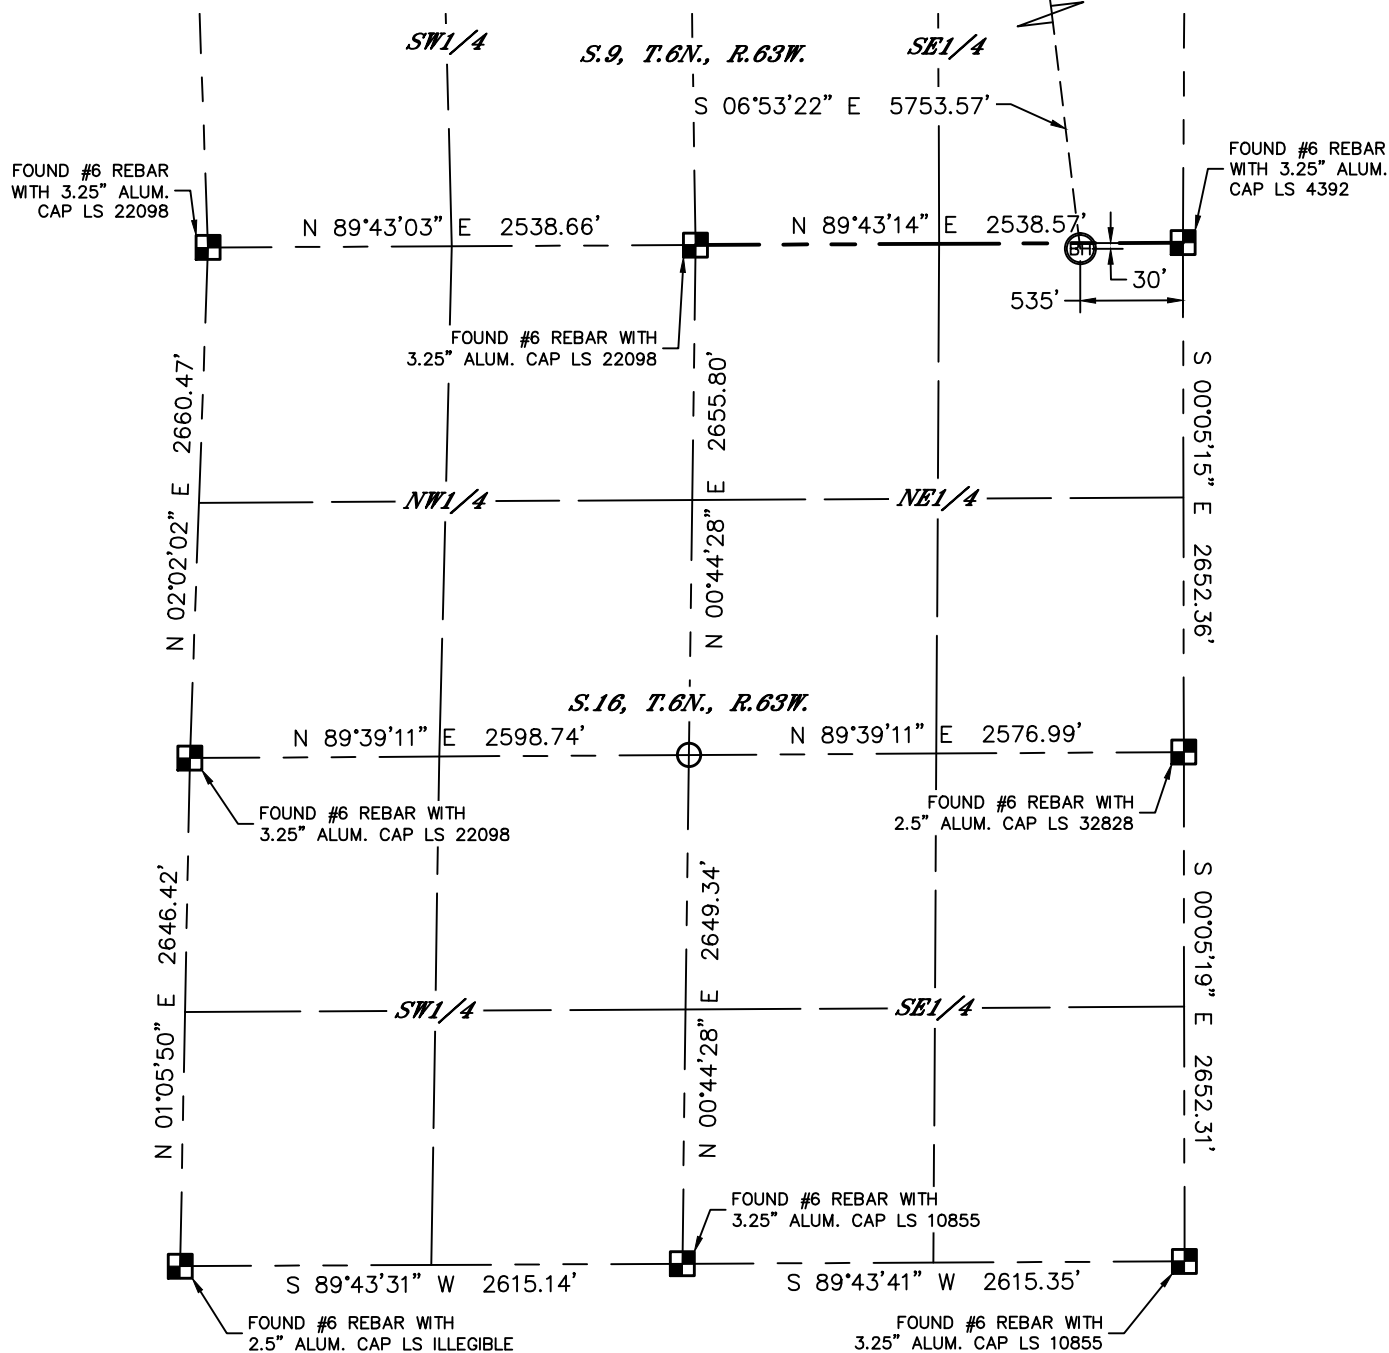


LEGEND

- = ALIQUOT MONUMENT AS DESCRIBED
- = CALCULATED POSITION

SHEET 3 OF 3

Brian T. Brinkman—
Colorado Licensed Professional
Land Surveyor No. 38175

DATE: 8/20/2014
PROJECT#: 2013042

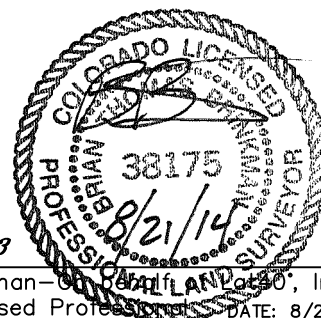




Lat40°, Inc. 1635 Foxtrail Drive, Suite 325 Loveland, CO 970-776-3321

SITE SKETCH


MAHALO STATE AA09-72-1AHNB

SECTION: 4
TOWNSHIP: 6N
RANGE: 63W

MAHALO STATE
AA09-72-1AHNB

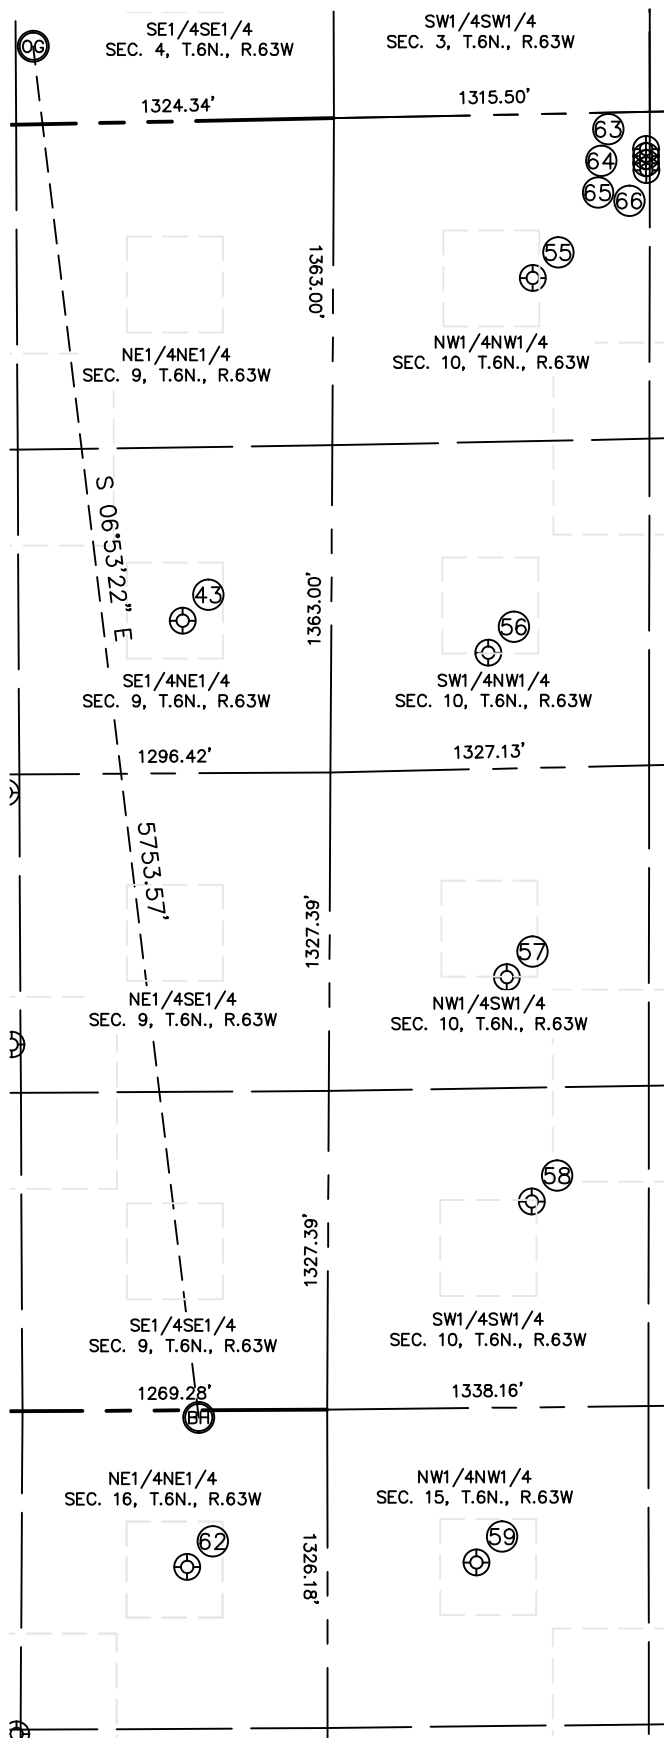

WELL #	WELL NAME	SHL FOOTAGE		SHL LAT °	SHL LONG °	PDOP	ELEV (FT.)	1/4/1/4
43	BASHOR PC AA 9-8	2080	FNL	40.50293	-104.43454	1.9	4694	SENE
55	CORNISH 11-10	683	FNL	40.50680	-104.42923	2.1	4696	NWNW
56	CORNISH 12-10	2239	FNL	40.50252	-104.42997	3.1	4690	SWNW
57	WALKER 13-10	1792	FSL	40.49881	-104.42975	2.2	4695	NWSW
58	WALKER 14-10	857	FSL	40.49624	-104.42942	2.2	4696	SWSW
59	WELLS RANCH USX AA 15-4	644	FNL	40.49212	-104.43031	2.1	4699	NWNW
62	BASHOR STATE AA 16-1	653	FNL	40.49211	-104.43464	1.9	4688	NENE
63	SCHAEFER 10E-223	155	FNL	40.50826	-104.42751	2.1	4698	NWNW
64	SCHAEFER 10M-243	184	FNL	40.50818	-104.42752	2.2	4698	NWNW
65	SCHAEFER 10J-403	214	FNL	40.50809	-104.42752	2.2	4698	NWNW
66	SCHAEFER 10J-203	243	FNL	40.50801	-104.42751	2.2	4698	NWNW

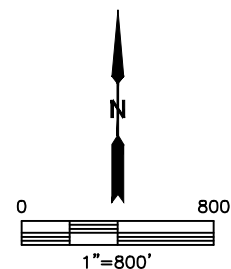

DATE: 8/20/2014
PROJECT#: 2013042