


KERR-MCGEE OIL AND GAS ONSHORE LP
GORDON FARMS 21-15
NE NW 15 2N 67W 990' FNL 1,635' FWL
WELD,COLORADO
09/08/2014

AREA: W1 ROUTE: W15 Spud: 12/22/1992 WINS No.: 74421 AFE/WO#: CANCELLED8844 API#: 0512316620

GL: 4979 KB: 4989 MTD: 8181 TVD: 8181 LOG MD: 8177 PBMD: 8138 PBTVD: 8138


Directions: WCR 22 & WCR 19, S 1/4, E 1/4 INTO

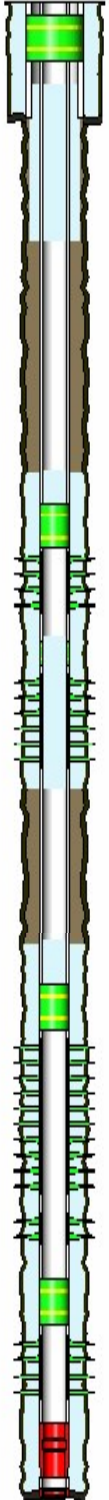

AREA: W1 ROUTE: W15 Spud: 12/22/1992 WINS No.: 74421 AFE/WO#: CANCELLED8844API#: 0512316620

GL: 4979 KB: 4989 MTD: 8181 TVD: 8181 LOG MD: 8177 PBMD: 8138 PBTVD: 8138

Directions: WCR 22 & WCR 19, S 1/4, E 1/4 INTO

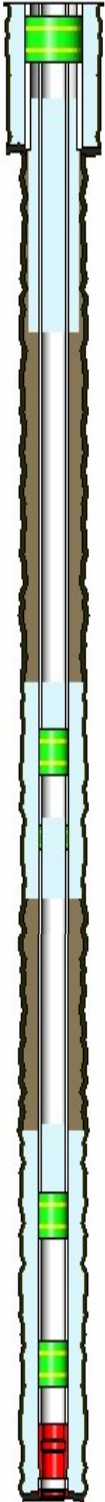

<u>HOLE SECTIONS</u>		<u>Size</u>	<u>Top</u>	<u>Btm</u>	<u>TD Date</u>			
SURFACE		12.25	10	675	12/22/1992			
PRODUCTION		7.88	675	8174	12/31/1992			
<u>TUBULARS</u>	<u>Tool Type</u>	<u>Joints</u>	<u>Size</u>	<u>Weight</u>	<u>Grade</u>	<u>Thread</u>	<u>Top D</u>	<u>Bottom D</u>
SURFACE CASING								
	Casing	16	8.63	24			10	670
PRODUCTION CASING								
	Casing	117	4.50	11.60	WC-70	LTC	10	4918
	Cement Stage Too	1	4.50				4918	4919
	Casing	77	4.50	11.60	WC-70	LTC	4919	8138
	Casing Float Collar	1	4.50				8138	8140
	Casing	1	4.50	11.60	WC-70	LTC	8140	8173
	Casing Guide Shoe	1	4.50				8173	8174
BRIDGE PLUG								
	Cast Iron Bridge Plu	1	4.50				7240	7242
BRIDGE PLUG								
	Cast Iron Bridge Plu	1	4.50				7940	7942
BRIDGE PLUG								
	CIBP With CMT Cap	1	4.50				4575	4577
BRIDGE PLUG								
	Cast Iron Bridge Plu	1	8.63				80	83
<u>CEMENT JOBS</u>	<u>Stage</u>	<u>Sacks</u>	<u>Cement Jobs</u>			<u>Top D</u>	<u>Btm D</u>	<u>cbf</u>
SURFACE CASING								
	STAGE 1 TAIL	150		REGULAR		400	675	No
	STAGE 1	220		LITE		10	400	No
PRODUCTION CASING								
	STAGE 2	225		A LITE		4255	4948	Yes
	STAGE 1	300		G		6820	8181	Yes
PRODUCTION CASING								
	SQUEEZE 1	125		G		4948	5250	Yes
	SQUEEZE 2	50		G		5100	5250	Yes
PRODUCTION CASING								
	ABANDONMENT PLUC	30	LEAD	FRESH WATER		6775	7240	No
PRODUCTION CASING								
	ABANDONMENT PLUC	75	LEAD	FRESH WATER		4863	5250	No
PRODUCTION CASING								
	ABANDONMENT PLUC	25	LEAD	FRESH WATER		4246	4575	No
SURFACE CASING								
	ABANDONMENT PLUC	540	LEAD	FRESH WATER		740	1900	No
SURFACE CASING								
	ABANDONMENT PLUC	125	LEAD	FRESH WATER		325	740	No
<u>PERFORATIONS</u>								
<u>Formation</u>	<u>Zone</u>	<u>Top</u>	<u>Btm</u>	<u>Date</u>	<u>Reason</u>	<u>Comments</u>		
SUSSEX		4606	4622	08/27/1998	PRODUCTION			
SUSSEX		4630	4642	08/27/1998	PRODUCTION			
SQUEEZE PERFS		4940	4941	08/17/1998	CEMENT SQUEEZE			
SHANNON		5020	5022	08/20/1998	PRODUCTION			
SHANNON		5028	5033	08/20/1998	PRODUCTION			
SHANNON		5038	5040	08/20/1998	PRODUCTION			
SQUEEZE PERFS		5250	5251	08/17/1998	CEMENT SQUEEZE			
NIORARA	B	7347	7348	11/02/1994	PRODUCTION			
NIORARA	B	7349	7350	11/02/1994	PRODUCTION			

KERR-MCGEE OIL AND GAS ONSHORE LP
GORDON FARMS 21-15
NE NW 15 2N 67W 990' FNL 1,635' FWL
WELD,COLORADO
09/08/2014

AREA: W1 ROUTE: W15 Spud: 12/22/1992 WINS No.: 74421 AFE/WO#: CANCELLED8844 API#: 0512316620

GL: 4979 KB: 4989 MTD: 8181 TVD: 8181 LOG MD: 8177 PBMD: 8138 PBTVD: 8138

Directions: WCR 22 & WCR 19, S 1/4, E 1/4 INTO

NIOBRARA	B	7357	7358	11/02/1994	PRODUCTION
NIOBRARA	B	7365	7366	11/02/1994	PRODUCTION
NIOBRARA	B	7371	7372	11/02/1994	PRODUCTION
CODELL		7572	7582	11/02/1994	PRODUCTION
CODELL		7574	7582	09/13/2001	PRODUCTION
J SAND		8005	8018	01/13/1993	PRODUCTION
J SAND		8030	8050	01/13/1993	PRODUCTION

Comments: