


LEASE WILLIAMS WELL NO. 2  
LOCATION SWSW 17-3N-51W COUNTY WYNNINGTON STATE CO  
OPERATOR BEREN CORPORATION FIELD HARDWAY  
ELEVATION: GR 4539' DF            KB 4551  
DATE DRILLED            ZERO MEASUREMENT           

API # 05-121-07270

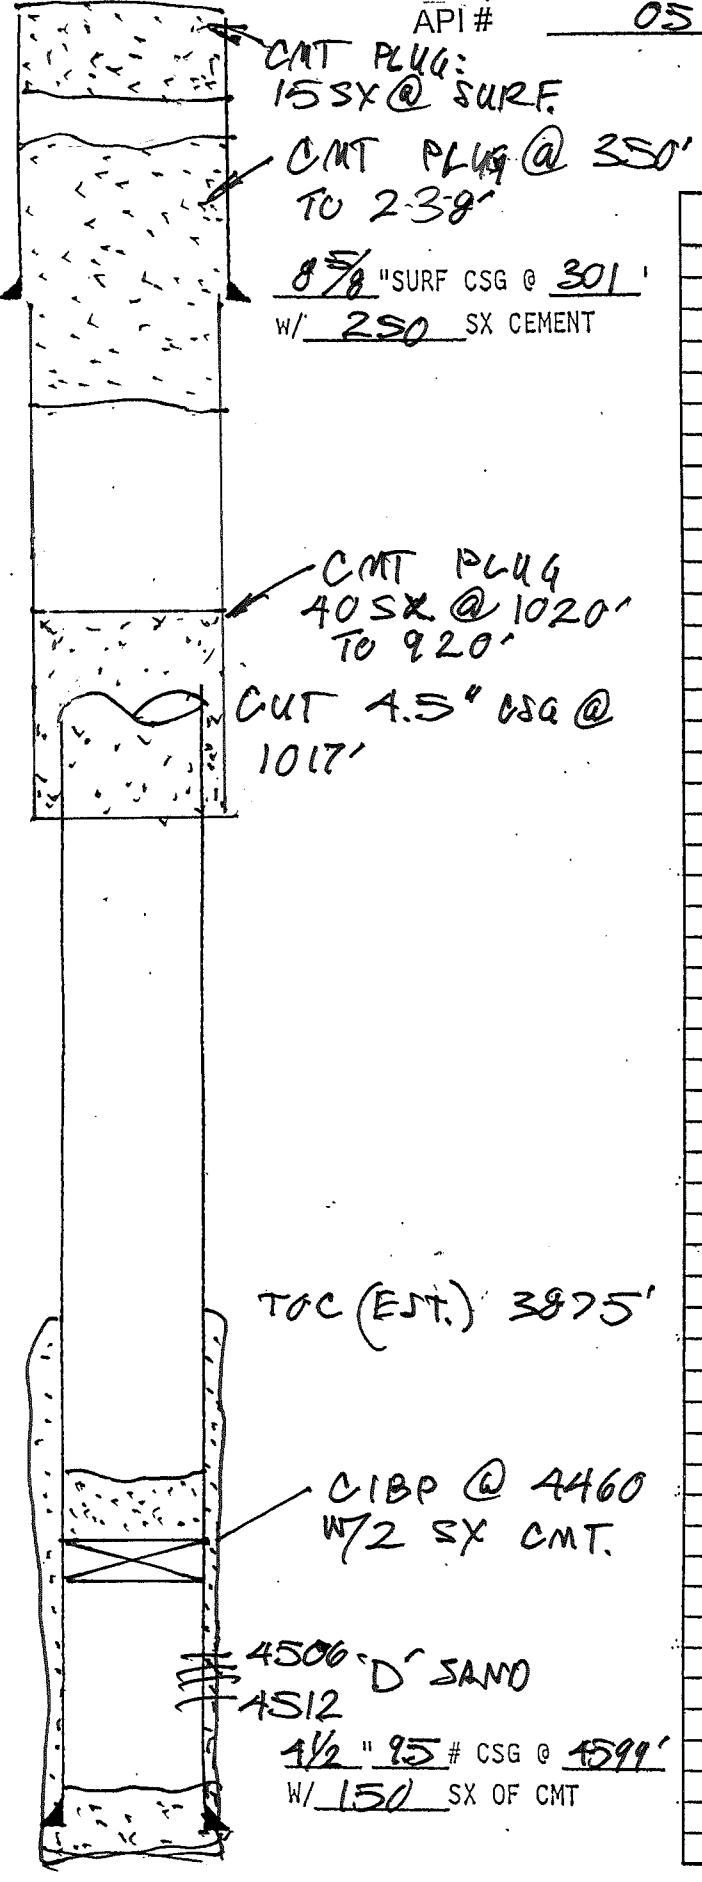

WELL BORE DIAGRAM

AS PLUGGED 08/26/2014

TD @ 4625'