


LEASE KLINGINSMITH WELL NO. 3
LOCATION NE SW 31-12N-57W COUNTY WELD STATE CO
OPERATOR BEREN CORP. FIELD VIGOR
ELEVATION: GR 5101 DF 5111 KB 5111
DATE DRILLED 5/78 ZERO MEASUREMENT 5111
API # 05-123-09494-00

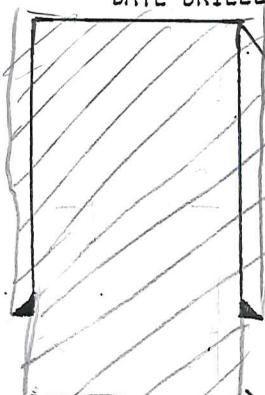


WELD PLATE ON TOP
OF SURF. CSG.

8 5/8" 24#
"SURF CSG @ 365'
W/ 360 SX CEMENT

PUMP 50 SX CMT
@ 400' - TAG CMT @
370' - PUMP 25 SX CMT
- TAG PLUG @ 287'
PUMP ADD'L 15' SX TO SURF.

CUT $\phi 4\frac{1}{2}$ CSG,
@ 1,000' PUMP 40
SX CMT

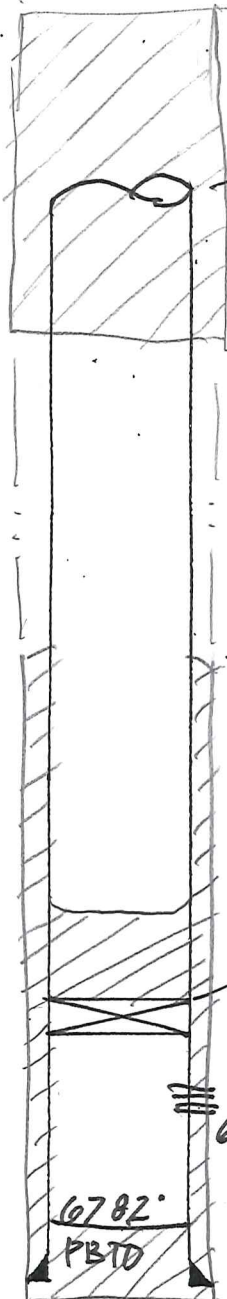

EST. T.O.C. @
6061'

CLBP @ 6720',
2 SX CMT ON DP

6761
6773 J SAND PERFS.

6782'
PBTD 4 1/2" 10.5# CSG @ 6785
W/ 150 SX OF CMT

TD: 6792'

KLINGINSMITH WBD

AS PLUGGED TO ABANDON

09/04/2014