




Lease Name: Shable #1-7

Legals: NENW – Sec. 7, T4N, R66W

County: Weld County, Colorado

API#: 05-123-13785

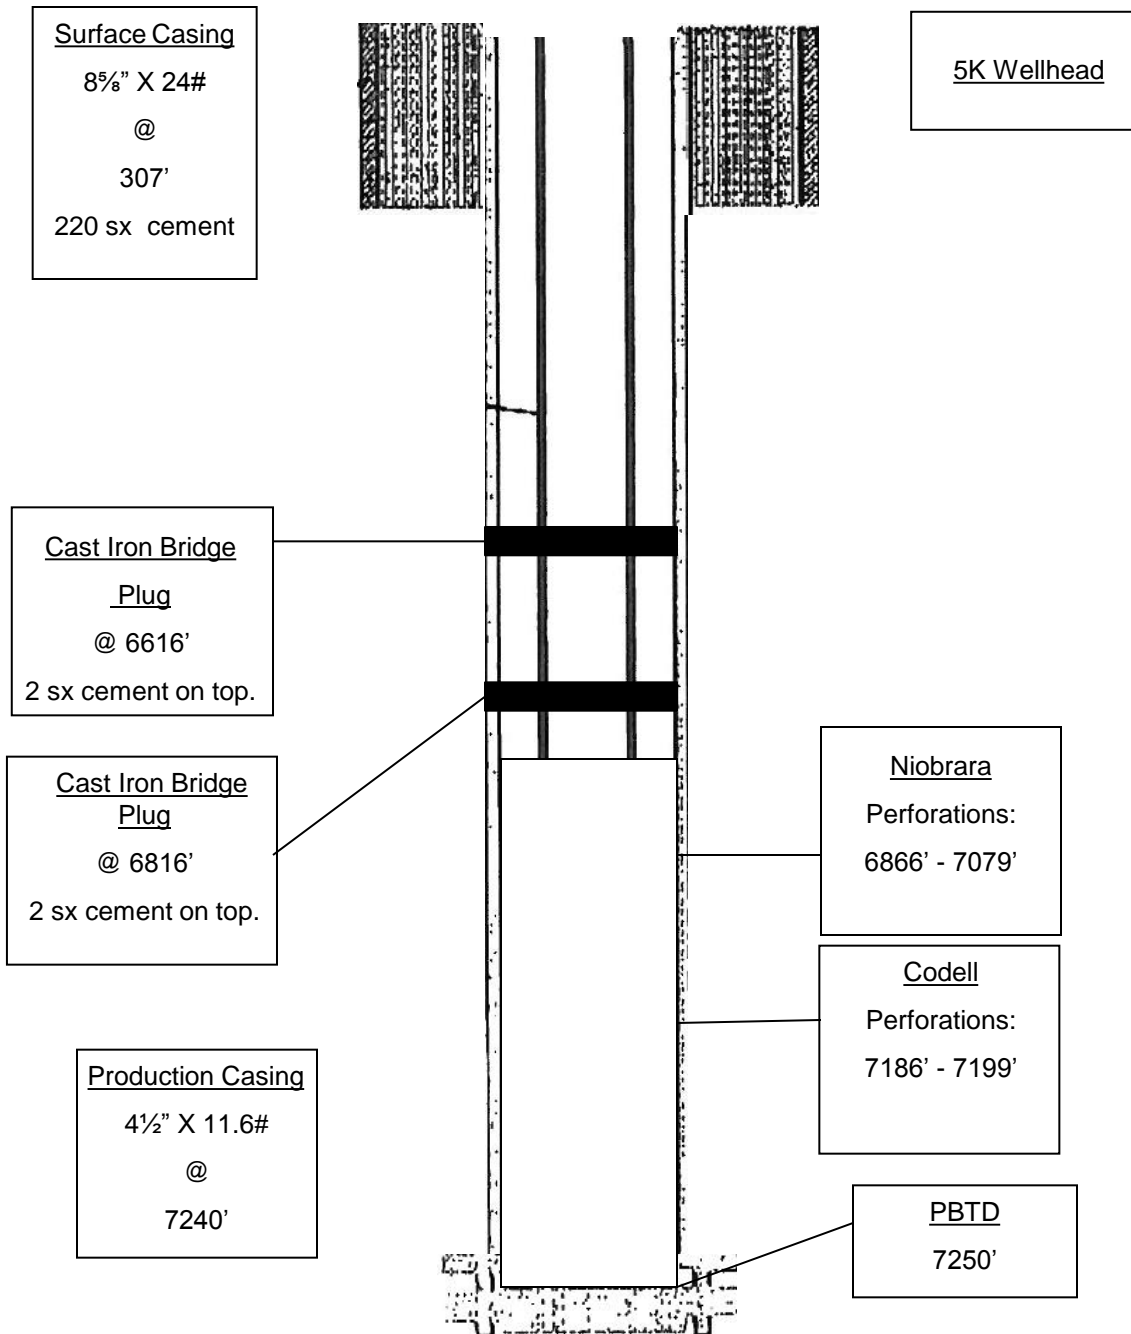

Wellbore Diagram