




Lease Name: Peterson #1-12

Legals: NENW – Sec. 12, T6N, R65W

County: Weld County, Colorado

API#: 05-123-13240

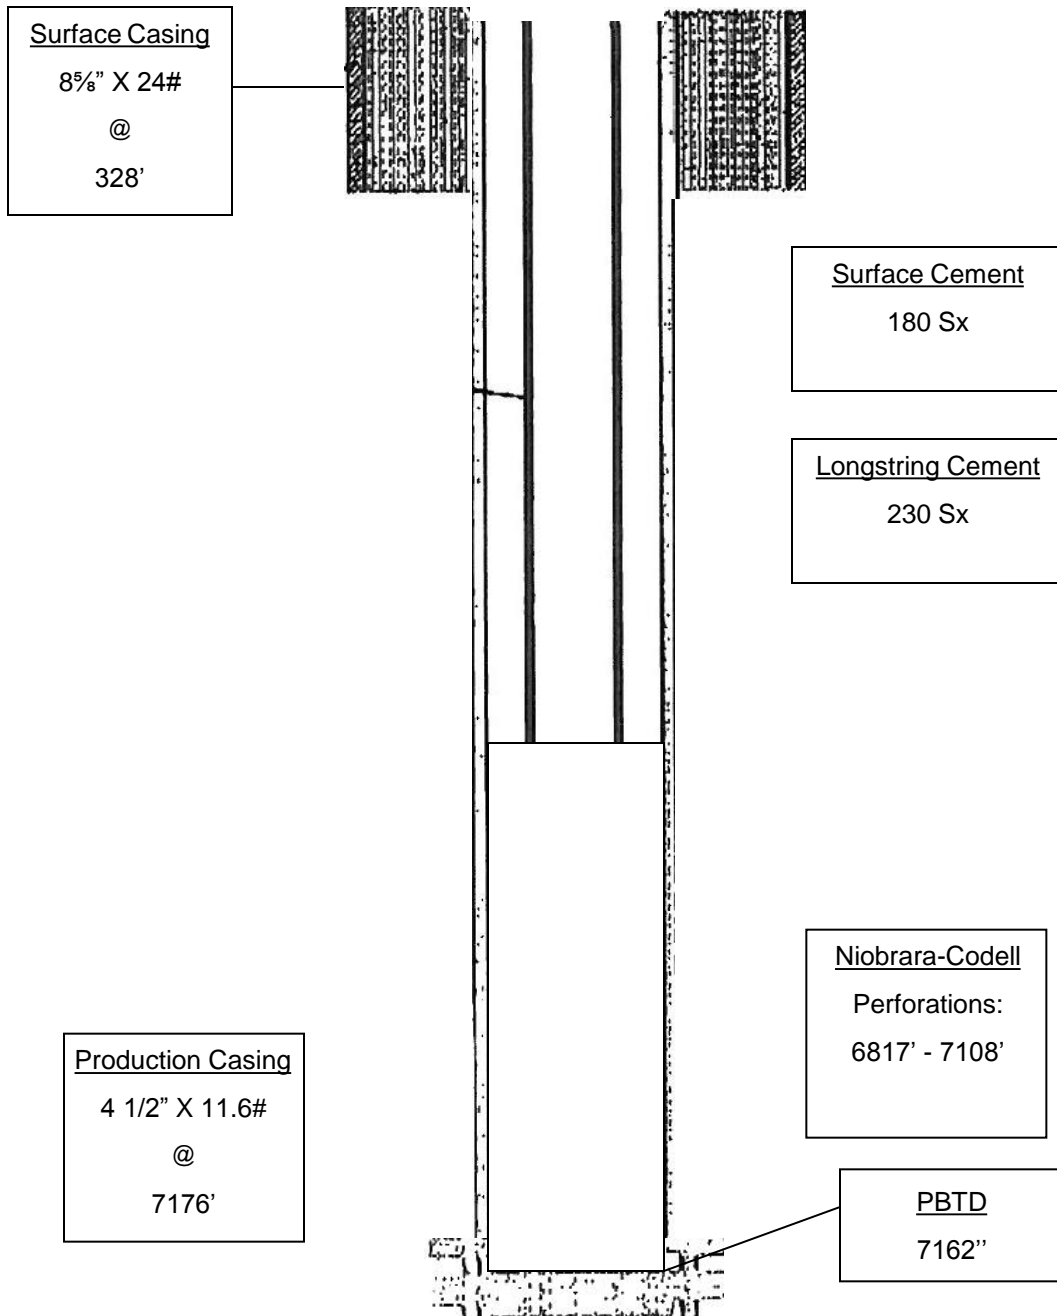

Wellbore Diagram