


**Well Name: SPIKE STATE H36-05**

VERTICAL - ORIGINAL HOLE, 10/1/2014 8:31:39 AM

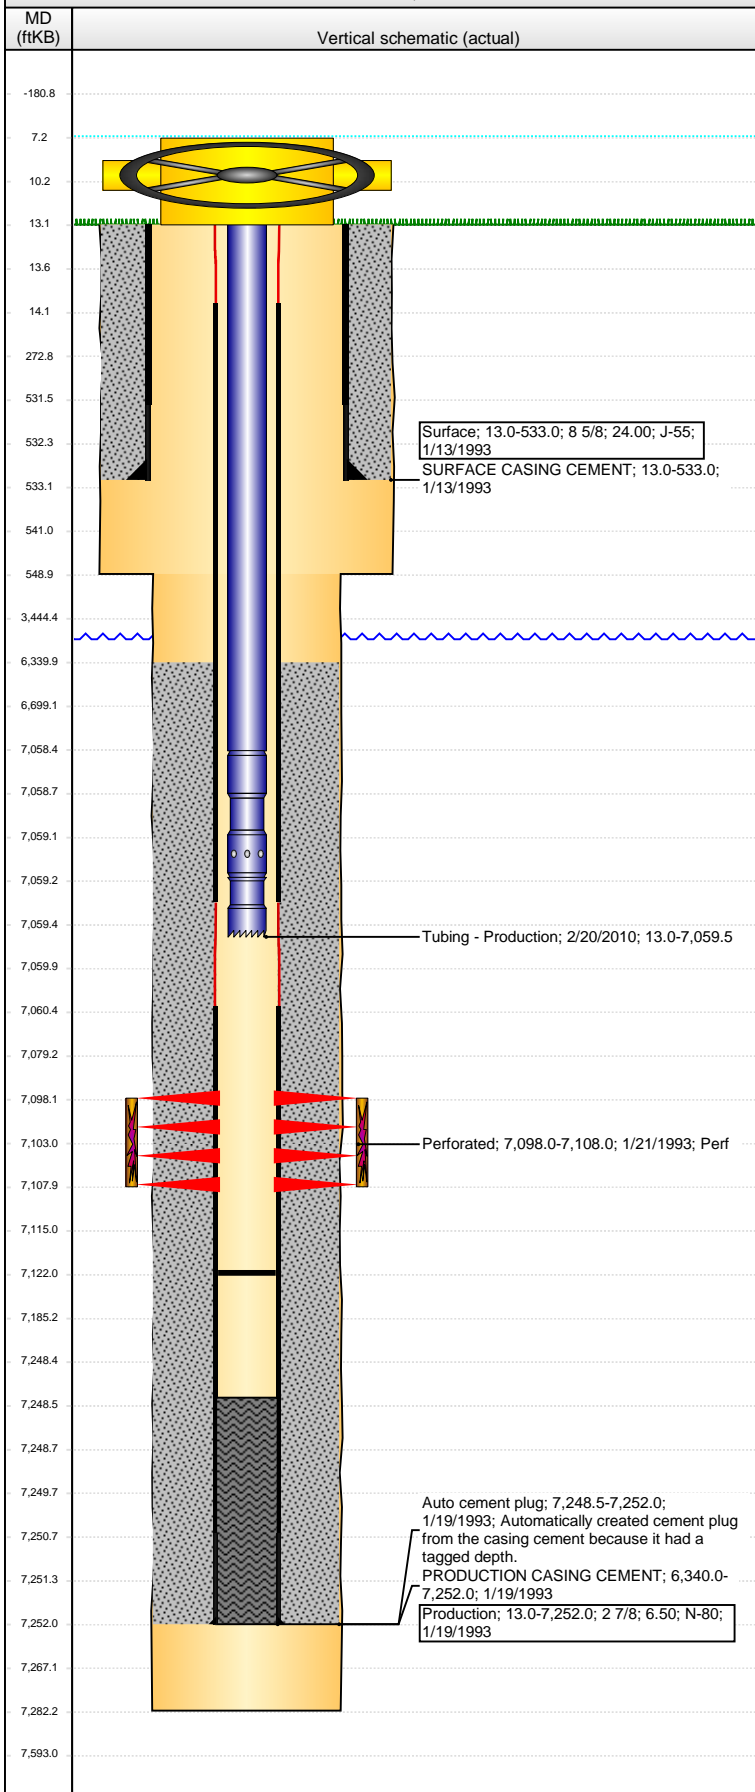

## Well Header

API	Business Unit	District	Well Config
05-123-16309	DJ BASIN	15	VERTICAL
Original KB Elevation (ft)	KB - GL / MSL (ftKB)	Spud Date	P & A Date
4,836.00	13.00	1/12/1993	
Comment			

Directions To Well  
RD 30 & 49 S. 2, W 1, N 7/10, E INTO.

## Congressional Location

Quarter 1	Quarter 2	Quarter 3	Quarter 4	Section	Township	Twntshp N...	Range	Rng E/W Dir
		NW	NE	36	3	N	65	W

## Bottom Hole Location

North-South Distance (ft)	From N or S Line	East-West Distance (ft)	From E or W Line

## Plug Back Total Depths

Date	Depth (ftKB)	Method	Com
1/19/1993	7,248.5	CASING TALLY	TOP OF FLOAT COLLAR
1/21/1993	7,237.0	CASED HOLE LOG	CBL DEPTH LOGGER
2/19/2010	7,122.0	TAG	MOST RECENT TAG OF FILL

## Wellbore Sections

Section Des	Size (in)	Act Top, MD (ftKB)	Act Btm, MD (ftKB)
SURFACE	12 1/4	13.0	549.0
PRODUCTION	7 7/8	549.0	7,282.0

## Zone Statuses

Zone Name	Status Date	Status	Job
CODELL	2/5/1993	PR	DRILLING/COMPLETION - ORIGINAL, 1/13/1993 00:00

## Casing Strings

### Surface, 533.0ftKB

Casing Description	Run Date	OD (in)	Wt/Len (l...)	Grade	Top, MD (ft...)	MD (ftKB)
Surface	1/13/1993	8 5/8	24.00	J-55	13.0	533.0

### Production, 7,252.0ftKB

Casing Description	Run Date	OD (in)	Wt/Len (l...)	Grade	Top, MD (ft...)	MD (ftKB)
Production	1/19/1993	2 7/8	6.50	N-80	13.0	7,252.0

## Cement

Description	Top Depth (ftKB)	Bottom Depth (ftKB)
SURFACE CASING CEMENT	13.0	533.0
Description	Top Depth (ftKB)	Bottom Depth (ftKB)
PRODUCTION CASING CEMENT	6,340.0	7,252.0

## Tubing Components

Item Des	OD (in)	Wt (lb/ft)	Grade	Jts	Len (ft)	Btm (ftKB)	Btm (TVD) (ftKB)
Tubing	1.66	2.30	J-55	214	7,045.30	7,058.3	
Landing Collar	1.66	2.30	N-80		0.90	7,059.2	
Notched collar	1.66	2.30	J-55		0.30	7,059.5	

## Perforation Data

Zone	Bnch/St g	Entered Shot Total	Top (ftKB)	Btm (ftKB)	Date
CODELL, ORIGINAL HOLE		40	7,098.00	7,108.00	1/21/1993

## Stimulations & Treatments

Date	Zone	Primary Job Type
1/21/1993	CODELL, ORIGINAL HOLE	DRILLING/COMPLETION - ORIGINAL
Technical Result	Tech Result Details	Tech Result Note
Success	According to Plan	
Comment		

## Other In Hole

Run Date	Des	OD (in)	Top (ftKB)	Btm (ftKB)

## Logs

Date	Type	Top, MD (ftKB)	Btm, MD (ftKB)
1/17/1993	COMPENSATED DENSITY	3,980.0	7,230.0
1/17/1993	INDUCTION	3,980.0	4,800.0
1/21/1993	CBL/CCL/GR	6,150.0	7,230.0