




**DRILLING COMPANY, INC.**  
**WICHITA, KANSAS**

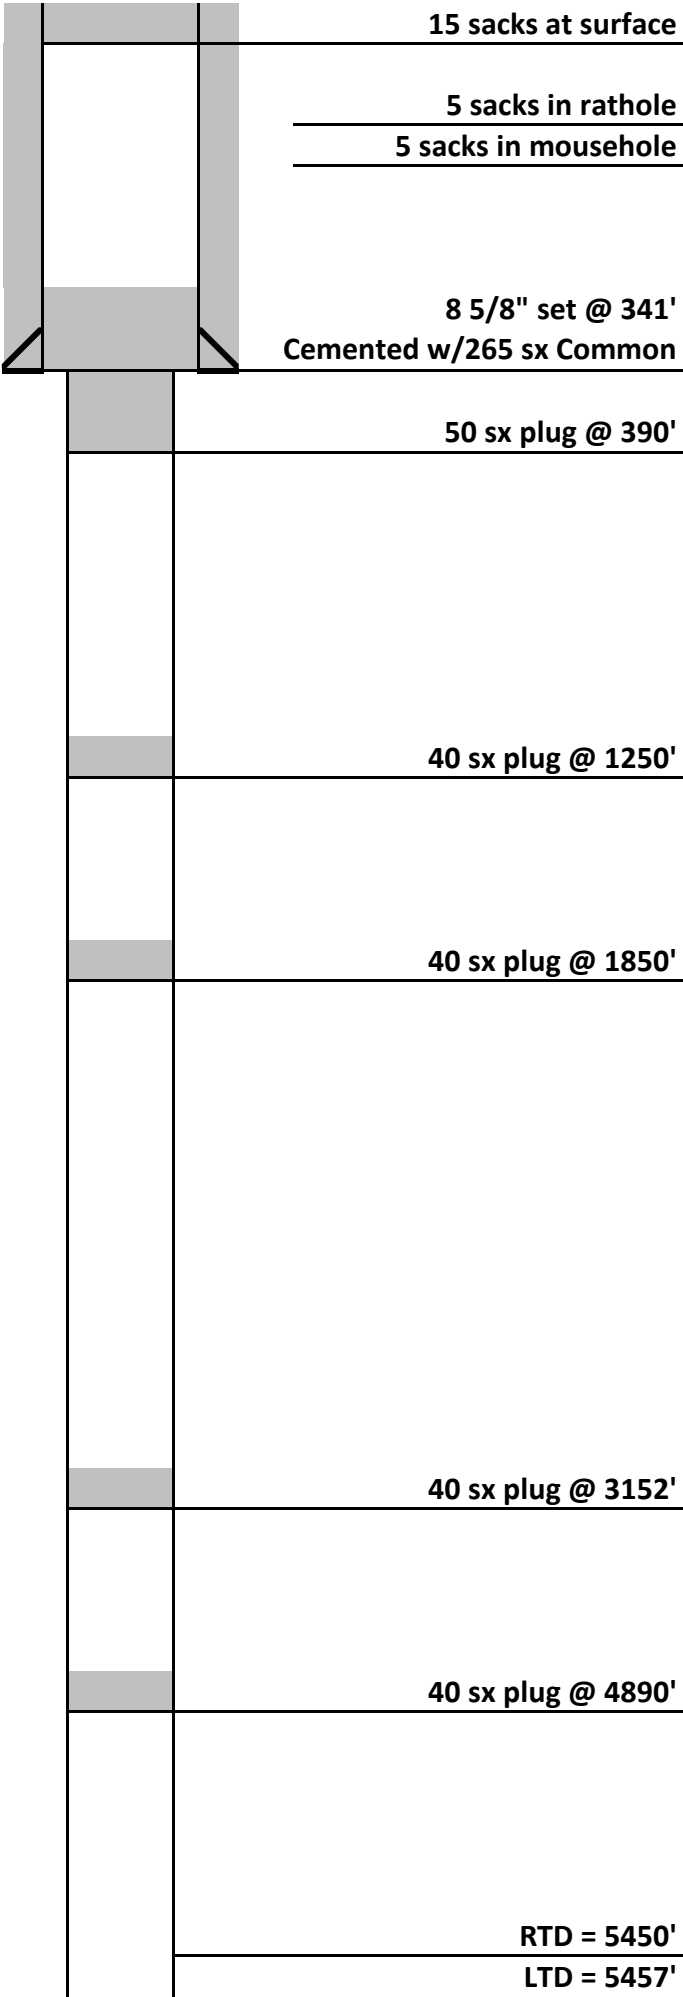

Date:	10/3/2014
Well Name:	Scherler #1-10
Location:	849' FNL & 952' FEL
	NE/4 NE/4 10-17S-45W
County:	Kiowa
State:	Colorado
API:	05-061-06893-00
Surface Casing:	8 5/8" set @ 341'
Cemented with:	265 sx Common
Total Depth:	5450'
Spud Date:	8/20/2014
P&A Date:	8/31/2014

LOG TOPS	
FORMATION	DEPTH
Dakota	1279
Cheyenne	1418
Stone Corral	2656
Shawnee	3790
Heebner Shale	3994
Lansing	4028
Marmaton	4420
Fort Scott	4512
Cherokee Shale	4584
Atoka	4742
Morrow Shale	4899
Keyes	4992
Mississippian	5260
Harrison Shale	5413
RTD	5450'
LTD	5457'