

## KERR-MCGEE OIL AND GAS ONSHORE LP

BADDING RED VV 15-3

NE NW 15 1N 67W 663' FNL 2,037' FWL

WELD,COLORADO

09/17/2014

AREA: W3

ROUTE: W31 Spud: 08/17/1993

WINS No.: 23165

AFE/WO#: 2099681

API#: 0512317214

GL: 5061

KB: 5071

MTD:


TVD:

LOG MD:

PBMD: 7806

PBTVD:

Directions: CR 10 &amp; CR 19, E 3/10, S 1/10, E INTO

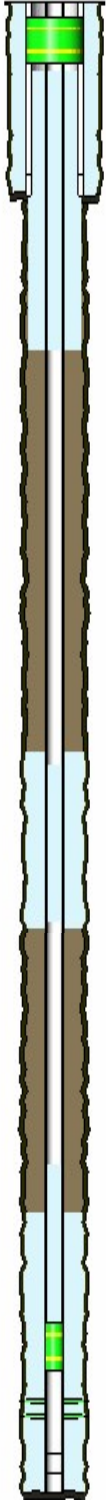

HOLE SECTIONS	Size	Top	Btm	TD Date
SURFACE	12.25	10	775	08/17/1993
PRODUCTION	7.88	775	7876	08/22/1993

TUBULARS	Tool Type	Joints	Size	Weight	Grade	Thread	Top D	Bottom D
SURFACE CASING	Casing	17	8.62	24.00			10	761
	Casing	1	8.62				761	763
PRODUCTION CASING	Casing	248	2.87	6.50	N-80		10	7852
	Casing	1	2.87				7852	7853
	Casing	1	2.87				7853	7854
	Casing							
BRIDGE PLUG	CIBP With CMT Cap	1	2.87				7580	7581
BRIDGE PLUG	Cast Iron Bridge Plu	1	8.63				80	83

CEMENT JOBS	Stage	Sacks	Cement Jobs	Top D	Btm D	chl
SURFACE CASING	PRIM CMT 1ST STAGE	530	LEAD FRESH WATER	10	763	No
PRODUCTION CASING	PRIM CMT 1ST STAGE	220	Lead FRESH WATER	4130	5200	Yes
	PRIM CMT 1ST STAGE	173	Tail FRESH WATER	6906	7854	Yes
PRODUCTION CASING	ABANDONMENT PLUC	30	LEAD FRESH WATER	6620	7570	No
PRODUCTION CASING		20	LEAD FRESH WATER	4765	5150	No
PRODUCTION CASING	ABANDONMENT PLUC	25	LEAD FRESH WATER	4210	4765	No
SURFACE CASING	ABANDONMENT PLUC	560	LEAD FRESH WATER	130	1700	No

PERFORATIONS	Formation	Zone	Top	Btm	Date	Reason	Comments
	CODELL		7702	7720	08/26/1993	PRODUCTION	
	CODELL		7703	7719	08/08/2004	PRODUCTION	

Comments: