
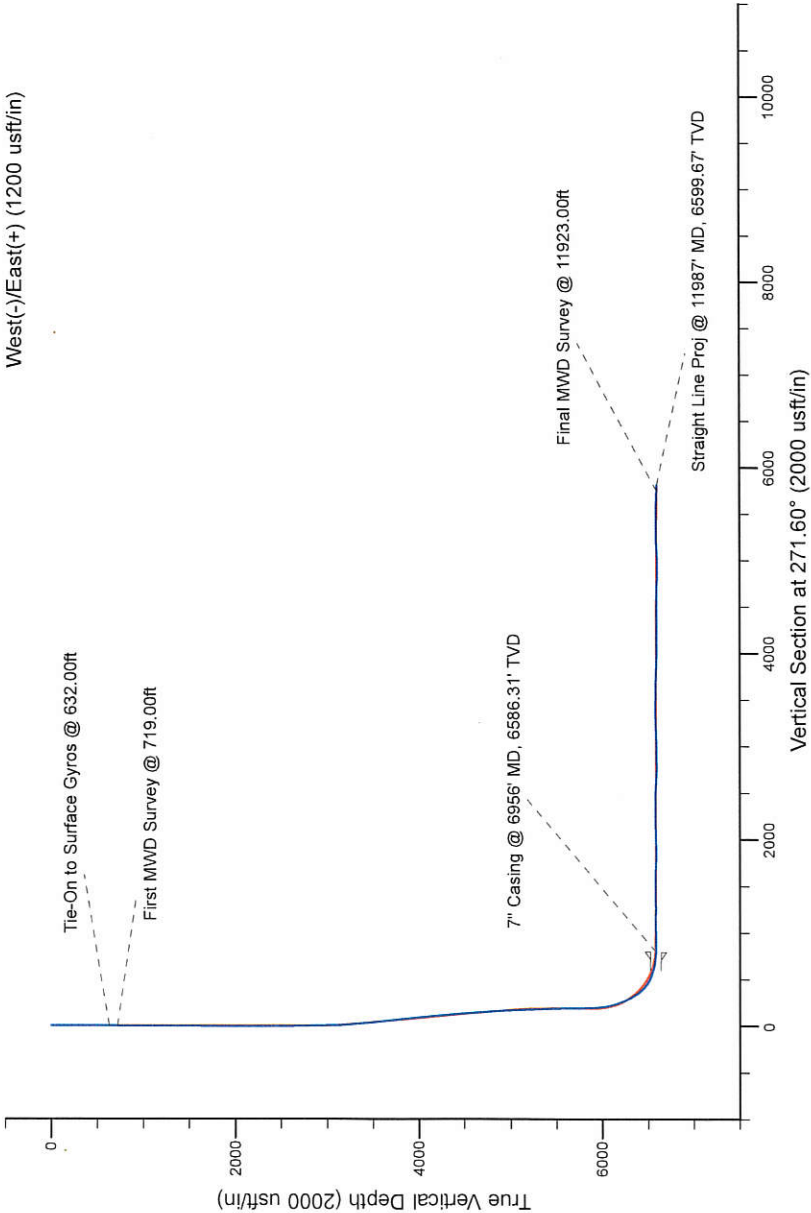


Project: Weld County, CO (NAD 83)  
Site: Sec. 29-T6N-R62W (Wells Ranch AE29-32-A PAD)  
Well: Wells Ranch AE30-65-1HNC  
Wellbore: Plan A  
Design: Final Surveys

# Noble Energy

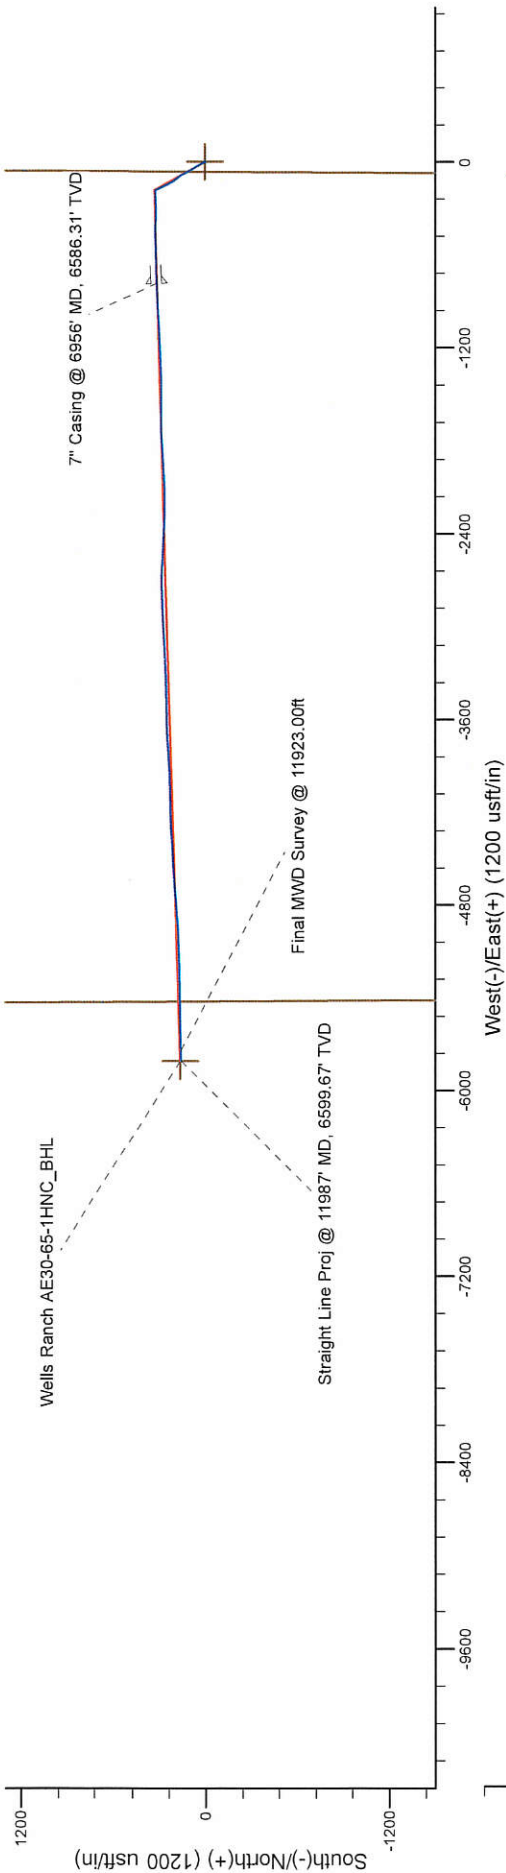

## LEGEND

- Wells Ranch AE30-65-1HNC, Plan A, Rev A0 - PROPOSAL V0
- Final Surveys

Platted SHL: 1978' FSL, 65' FWL  
Platted Lat/Long: 40.45584 N, 104.35617 W  
Location: Sec. 29-T6N-R62W

7" Casing: ~2318.75' FSL, ~723.61' FEL  
Lat/Long: 40.456743 N, 104.358979 W  
State Planes - CO Northern: 1,411,274.60' N, 3,317,511.57' E  
Location: Sec. 30-T6N-R62W

BHL: ~2304.66' FSL, ~383.38' FEL  
Lat/Long: 40.456476 N, 104.377037 W  
State Planes - CO Northern: 1,411,113.36' N, 3,312,487.95' E  
Location: Sec. 25-T6N-R63W

WELL DETAILS: Wells Ranch AE30-65-1HNC

Ground Level: 4757.00  
RKB=30ft @ 4787.00usft (H&P 321)

Created By: Fred Hartmann  
Created On: 04/16/2014

# Noble Energy

Weld County, CO (NAD 83)

Sec. 29-T6N-R62W (Wells Ranch AE29-32-A PAD)

Wells Ranch AE30-65-1HNC

Design: Final Surveys

## Sperry Drilling Services

### Final Survey Report

16 April, 2014

Well Coordinates: 1,410,955.76 N, 3,318,297.27 E (40° 27' 21.02" N, 104° 21' 22.21" W)

Ground Level: 4,757.00 usft

Local Coordinate Origin:

Viewing Datum:

TVDs to System:

North Reference:

Unit System:

Geodetic Scale Factor Applied

Version: 5000.1 Build: 70

Centered on Well Wells Ranch AE30-65-1HNC

RKB=30ft @ 4787.00usft (H&P 321)

N

Grid

Dec-Deg - API - US Survey Feet - Custom

**HALLIBURTON**

## Design Report for Wells Ranch AE30-65-1HNC - Final Surveys

Measured Depth (usft)	Inclination (°)	Azimuth (°)	Vertical Depth (usft)	+N/-S (usft)	+E/-W (usft)	Vertical Section (usft)	Dogleg Rate (°/100usft)
0.00	0.00	0.00	0.00	0.00	0.00	0.00	0.00
214.00	0.50	294.17	214.00	0.38	-0.85	0.86	0.23
420.00	0.70	270.67	419.99	0.77	-2.93	2.95	0.15
632.00	0.50	161.77	631.98	-0.10	-3.94	3.93	0.46
<b>Tie-On to Surface Gyros @ 632.00ft</b>							
719.00	0.99	181.59	718.97	-1.21	-3.84	3.80	0.63
<b>First MWD Survey @ 719.00ft</b>							
811.00	0.45	64.28	810.97	-1.85	-3.53	3.48	1.37
902.00	0.57	54.36	901.96	-1.43	-2.84	2.80	0.16
994.00	0.61	46.27	993.96	-0.82	-2.12	2.09	0.10
1,086.00	0.50	35.90	1,085.95	-0.16	-1.53	1.52	0.16
1,179.00	0.62	44.81	1,178.95	0.53	-0.94	0.95	0.16
1,272.00	0.61	46.31	1,271.94	1.22	-0.22	0.26	0.02
1,364.00	0.64	37.61	1,363.94	1.97	0.44	-0.39	0.11
1,456.00	0.92	46.30	1,455.93	2.89	1.29	-1.21	0.33
1,548.00	0.41	187.23	1,547.93	3.07	1.78	-1.70	1.37
1,640.00	0.28	163.01	1,639.93	2.53	1.81	-1.74	0.21
1,735.00	0.37	154.48	1,734.92	2.03	2.01	-1.95	0.11
1,830.00	0.34	165.54	1,829.92	1.48	2.21	-2.17	0.08
1,924.00	0.17	191.15	1,923.92	1.07	2.25	-2.22	0.21
2,019.00	0.19	100.65	2,018.92	0.91	2.38	-2.35	0.27
2,114.00	0.34	100.57	2,113.92	0.83	2.81	-2.79	0.16
2,209.00	0.50	130.71	2,208.92	0.50	3.40	-3.39	0.28
2,303.00	0.59	249.19	2,302.92	0.06	3.26	-3.26	1.00
2,398.00	0.33	220.81	2,397.91	-0.32	2.63	-2.63	0.36
2,492.00	0.26	234.46	2,491.91	-0.65	2.28	-2.29	0.11
2,587.00	0.39	216.14	2,586.91	-1.03	1.91	-1.94	0.17
2,682.00	0.40	230.61	2,681.91	-1.50	1.46	-1.50	0.11
2,777.00	1.28	291.00	2,776.90	-1.33	0.22	-0.25	1.20
2,871.00	2.09	335.39	2,870.86	0.60	-1.48	1.49	1.57
2,966.00	4.42	336.18	2,965.70	5.53	-3.68	3.83	2.45
3,061.00	5.08	340.10	3,060.37	12.83	-6.59	6.94	0.77
3,156.00	6.89	332.70	3,154.85	21.85	-10.63	11.24	2.07
3,251.00	8.73	336.21	3,248.97	33.51	-16.16	17.09	2.00
3,346.00	10.15	325.42	3,342.69	47.00	-23.82	25.12	2.38
3,440.00	7.58	323.79	3,435.56	58.82	-32.18	33.81	2.75
3,535.00	7.48	325.06	3,529.74	68.95	-39.42	41.34	0.20
3,630.00	11.03	328.21	3,623.49	81.75	-47.76	50.02	3.77
3,724.00	13.18	332.06	3,715.39	98.86	-57.52	60.26	2.44
3,818.00	14.06	332.58	3,806.75	118.46	-67.79	71.08	0.95
3,913.00	13.10	332.20	3,899.09	138.23	-78.13	81.97	1.01
4,007.00	9.85	330.42	3,991.20	154.65	-87.07	91.36	3.48
4,102.00	8.01	325.99	4,085.05	167.20	-94.78	99.42	2.07
4,197.00	7.36	324.22	4,179.19	177.63	-102.04	106.97	0.73
4,292.00	7.35	320.43	4,273.41	187.25	-109.47	114.67	0.51
4,387.00	7.55	319.69	4,367.61	196.69	-117.38	122.84	0.23
4,481.00	8.68	327.92	4,460.67	207.41	-125.14	130.90	1.72
4,576.00	7.57	330.34	4,554.71	218.92	-132.05	138.12	1.22
4,671.00	8.57	331.24	4,648.77	230.57	-138.55	144.94	1.06
4,766.00	9.46	336.19	4,742.60	243.91	-145.11	151.87	1.24



## Design Report for Wells Ranch AE30-65-1HNC - Final Surveys

Measured Depth (usft)	Inclination (°)	Azimuth (°)	Vertical Depth (usft)	+N/-S (usft)	+E/-W (usft)	Vertical Section (usft)	Dogleg Rate (°/100usft)
4,861.00	8.61	335.93	4,836.42	257.55	-151.16	158.30	0.90
4,956.00	7.51	334.20	4,930.48	269.63	-156.76	164.24	1.19
5,050.00	5.12	331.41	5,023.90	278.85	-161.44	169.18	2.56
5,145.00	4.68	331.78	5,118.56	285.98	-165.31	173.24	0.46
5,239.00	5.94	339.40	5,212.15	293.92	-168.83	176.98	1.53
5,334.00	6.08	338.06	5,306.63	303.18	-172.44	180.85	0.21
5,429.00	4.95	333.55	5,401.19	311.52	-176.14	184.79	1.27
5,524.00	3.19	333.94	5,495.95	317.57	-179.13	187.94	1.85
5,619.00	2.13	325.61	5,590.84	321.40	-181.29	190.21	1.18
5,714.00	1.42	325.60	5,685.80	323.83	-182.95	191.94	0.75
5,809.00	0.94	322.30	5,780.78	325.41	-184.09	193.12	0.51
5,857.00	0.81	312.55	5,828.77	325.95	-184.58	193.63	0.41
5,919.00	0.65	302.66	5,890.76	326.44	-185.20	194.26	0.33
5,997.00	4.17	277.03	5,968.68	327.03	-188.39	197.46	4.61
6,045.00	8.85	268.41	6,016.36	327.14	-193.82	202.89	9.93
6,091.00	11.75	268.39	6,061.62	326.91	-202.04	211.10	6.30
6,139.00	15.63	268.44	6,108.24	326.59	-213.39	222.44	8.08
6,186.00	18.54	265.93	6,153.17	325.89	-227.18	236.20	6.39
6,234.00	20.49	266.24	6,198.41	324.80	-243.17	252.16	4.07
6,281.00	22.54	266.89	6,242.13	323.77	-260.38	269.33	4.39
6,329.00	25.96	265.64	6,285.89	322.47	-280.05	288.96	7.20
6,375.00	28.05	268.40	6,326.87	321.40	-300.90	309.77	5.30
6,423.00	32.40	272.57	6,368.34	321.67	-325.04	333.91	10.06
6,470.00	37.71	273.92	6,406.80	323.21	-351.98	360.88	11.42
6,518.00	45.25	273.26	6,442.74	325.19	-383.69	392.64	15.73
6,565.00	50.22	271.54	6,474.34	326.63	-418.43	427.40	10.92
6,613.00	56.97	268.86	6,502.81	326.72	-457.03	465.99	14.76
6,660.00	65.63	267.54	6,525.36	325.41	-498.20	507.10	18.59
6,708.00	71.52	266.91	6,542.89	323.24	-542.81	551.64	12.33
6,755.00	73.80	269.09	6,556.90	321.68	-587.64	596.41	6.57
6,803.00	77.58	271.08	6,568.76	321.76	-634.14	642.89	8.84
6,850.00	80.30	270.42	6,577.78	322.36	-680.26	689.01	5.95
6,911.00	86.86	267.18	6,584.59	321.08	-740.82	749.51	11.98
6,956.00	88.78	267.14	6,586.31	318.85	-785.73	794.34	4.26
<b>7" Casing @ 6956' MD, 6586.31' TVD</b>							
6,992.00	90.31	267.10	6,586.59	317.04	-821.68	830.23	4.26
7,085.00	90.40	266.41	6,586.02	311.78	-914.53	922.89	0.75
7,177.00	90.28	266.84	6,585.47	306.36	-1,006.37	1,014.54	0.49
7,269.00	89.97	267.01	6,585.27	301.42	-1,098.24	1,106.24	0.38
7,361.00	90.31	266.83	6,585.05	296.48	-1,190.10	1,197.93	0.42
7,453.00	90.89	266.89	6,584.08	291.44	-1,281.96	1,289.61	0.63
7,548.00	90.28	269.02	6,583.11	288.05	-1,376.89	1,384.41	2.33
7,643.00	90.65	270.54	6,582.34	287.69	-1,471.88	1,479.35	1.65
7,737.00	89.48	270.79	6,582.24	288.78	-1,565.87	1,573.34	1.27
7,832.00	87.41	268.35	6,584.81	288.07	-1,660.82	1,668.23	3.37
7,926.00	88.30	267.76	6,588.33	284.88	-1,754.70	1,761.98	1.14
8,021.00	89.11	266.99	6,590.48	280.53	-1,849.58	1,856.70	1.18
8,116.00	91.08	265.96	6,590.32	274.69	-1,944.39	1,951.31	2.34
8,211.00	92.19	266.11	6,587.61	268.12	-2,039.12	2,045.82	1.18
8,305.00	92.37	268.54	6,583.87	263.74	-2,132.94	2,139.48	2.59
8,400.00	91.29	270.93	6,580.84	263.30	-2,227.88	2,234.37	2.76

## Design Report for Wells Ranch AE30-65-1HNC - Final Surveys

Measured Depth (usft)	Inclination (°)	Azimuth (°)	Vertical Depth (usft)	+N/-S (usft)	+E/-W (usft)	Vertical Section (usft)	Dogleg Rate (°/100usft)
8,495.00	89.72	271.93	6,580.00	265.67	-2,322.84	2,329.37	1.96
8,590.00	87.38	272.88	6,582.40	269.66	-2,417.72	2,424.32	2.66
8,685.00	87.01	273.06	6,587.05	274.57	-2,512.48	2,519.18	0.43
8,779.00	88.43	273.13	6,590.79	279.64	-2,606.27	2,613.07	1.51
8,874.00	88.46	271.68	6,593.37	283.63	-2,701.15	2,708.02	1.53
8,969.00	87.50	267.58	6,596.72	283.02	-2,796.06	2,802.89	4.43
9,063.00	90.59	266.50	6,598.29	278.16	-2,889.91	2,896.56	3.48
9,158.00	92.25	266.05	6,595.93	271.99	-2,984.68	2,991.12	1.81
9,253.00	92.34	267.56	6,592.13	266.70	-3,079.45	3,085.71	1.59
9,347.00	92.25	267.42	6,588.36	262.59	-3,173.29	3,179.39	0.18
9,442.00	91.82	268.22	6,584.99	258.98	-3,268.16	3,274.12	0.96
9,537.00	90.43	268.57	6,583.13	256.32	-3,363.10	3,368.95	1.51
9,632.00	88.55	268.29	6,583.97	253.72	-3,458.06	3,463.80	2.00
9,726.00	90.49	269.10	6,584.76	251.57	-3,552.02	3,557.67	2.24
9,821.00	87.81	267.92	6,586.17	249.11	-3,646.97	3,652.51	3.08
9,916.00	86.11	266.79	6,591.21	244.73	-3,741.73	3,747.11	2.15
10,011.00	88.00	265.49	6,596.09	238.34	-3,836.38	3,841.55	2.41
10,106.00	91.39	267.50	6,596.59	232.53	-3,931.19	3,936.15	4.15
10,201.00	90.03	268.78	6,595.41	229.45	-4,026.12	4,030.97	1.97
10,296.00	89.38	269.37	6,595.90	227.92	-4,121.11	4,125.87	0.92
10,391.00	90.00	268.54	6,596.42	226.19	-4,216.09	4,220.77	1.09
10,485.00	89.66	265.69	6,596.70	221.46	-4,309.96	4,314.47	3.05
10,580.00	91.60	266.12	6,595.65	214.67	-4,404.71	4,408.99	2.09
10,675.00	90.15	267.56	6,594.20	209.44	-4,499.55	4,503.65	2.15
10,770.00	89.41	267.00	6,594.57	204.93	-4,594.44	4,598.37	0.98
10,864.00	87.63	266.01	6,596.99	199.20	-4,688.23	4,691.97	2.17
10,959.00	88.06	264.69	6,600.57	191.50	-4,782.85	4,786.33	1.46
11,054.00	87.99	266.20	6,603.84	183.96	-4,877.49	4,880.72	1.59
11,148.00	91.79	265.95	6,604.02	177.53	-4,971.25	4,974.27	4.05
11,243.00	93.51	267.77	6,599.63	172.33	-5,066.00	5,068.84	2.63
11,337.00	92.50	268.95	6,594.70	169.65	-5,159.83	5,162.55	1.65
11,432.00	91.26	268.68	6,591.58	167.68	-5,254.75	5,257.39	1.34
11,527.00	89.91	269.48	6,590.61	166.16	-5,349.73	5,352.29	1.65
11,622.00	89.38	268.89	6,591.20	164.81	-5,444.72	5,447.20	0.83
11,717.00	87.75	269.06	6,593.58	163.11	-5,539.67	5,542.07	1.73
11,811.00	88.46	268.81	6,596.69	161.36	-5,633.60	5,635.91	0.80
11,906.00	89.14	268.83	6,598.68	159.41	-5,728.56	5,730.78	0.72
11,923.00	89.32	268.71	6,598.91	159.04	-5,745.56	5,747.76	1.27
Final MWD Survey @ 11923.00ft							
11,987.00	89.32	268.71	6,599.67	157.60	-5,809.54	5,811.67	0.00
Straight Line Proj @ 11987' MD, 6599.67' TVD							

Design Annotations

Measured Depth (usft)	Vertical Depth (usft)	Local Coordinates		Comment
		+N/-S (usft)	+E/-W (usft)	
632.00	631.98	-0.10	-3.94	Tie-On to Surface Gyros @ 632.00ft
719.00	718.97	-1.21	-3.84	First MWD Survey @ 719.00ft
11,923.00	6,598.91	159.04	-5,745.56	Final MWD Survey @ 11923.00ft
11,987.00	6,599.67	157.60	-5,809.54	Straight Line Proj @ 11987' MD, 6599.67' TVD

## Design Report for Wells Ranch AE30-65-1HNC - Final Surveys

Vertical Section Information

Angle Type	Target	Azimuth (°)	Origin Type	Origin +N/-S (usft)	Origin +E/-W (usft)	Start TVD (usft)
Target	Wells Ranch AE30-65-1HNC_BHL	271.60	Slot	0.00	0.00	0.00

Survey tool program

From (usft)	To (usft)	Survey/Plan	Survey Tool
214.00	632.00	Surface Gyros	Flexi-Shot
719.00	6,911.00	MWD Surveys - Intermediate	MWD+IFR1+MS_WY
6,992.00	11,923.00	MWD Surveys - Production	MWD+IFR1+MS_WY

Casing Details

Measured Depth (usft)	Vertical Depth (usft)	Name	Casing Diameter (")	Hole Diameter (")
6,956.00	6,586.31	7" Casing @ 6956' MD, 6586.31' TVD	7	8-3/4

Wellbore Targets

Target Name - hit/miss target - Shape	Dip Angle (°)	Dip Dir. (°)	TVD (usft)	+N/-S (usft)	+E/-W (usft)	Northing (usft)	Easting (usft)	Latitude	Longitude
Wells Ranch AE30-65- - actual wellpath hits target center - Polygon	0.00	0.00	0.00	0.00	0.00	1,410,955.76	3,318,297.27	40.455840	-104.356170
Point 1				0.00	3,106.53	-10,734.29	1,414,062.18	3,307,563.38	
Point 2				0.00	-2,208.66	-10,687.51	1,408,747.18	3,307,610.16	
Point 3				0.00	-2,142.35	-5,413.86	1,408,813.49	3,312,883.61	
Point 4				0.00	3,162.13	-5,442.16	1,414,117.78	3,312,855.31	
Point 5				0.00	-2,142.35	-5,413.86	1,408,813.49	3,312,883.61	
Point 6				0.00	-1,979.36	-74.67	1,408,976.48	3,318,222.61	
Point 7				0.00	3,322.25	-45.64	1,414,277.89	3,318,251.64	
Point 8				0.00	3,162.13	-5,442.16	1,414,117.78	3,312,855.31	
Point 9				0.00	3,106.53	-10,734.29	1,414,062.18	3,307,563.38	
Wells Ranch AE30-65- - actual wellpath hits target center - Polygon	0.00	0.00	0.00	0.00	0.00	1,410,955.76	3,318,297.27	40.455840	-104.356170
Point 1				0.00	2,702.12	-4,982.15	1,413,657.78	3,313,315.31	
Point 2				0.00	-1,682.34	-4,953.85	1,409,273.49	3,313,343.61	
Point 3				0.00	-1,519.34	-534.68	1,409,436.48	3,317,762.61	
Point 4				0.00	2,862.23	-505.65	1,413,817.89	3,317,791.64	
Point 5				0.00	2,702.12	-4,982.15	1,413,657.78	3,313,315.31	
Wells Ranch AE30-65- - actual wellpath hits target center - Polygon	0.00	0.00	0.00	0.00	0.00	1,410,955.76	3,318,297.27	40.455840	-104.356170
Point 1				0.00	2,646.51	-10,274.27	1,413,602.18	3,308,023.38	
Point 2				0.00	-1,748.65	-10,227.49	1,409,207.18	3,308,070.16	
Point 3				0.00	-1,682.34	-5,873.88	1,409,273.49	3,312,423.61	
Point 4				0.00	2,702.12	-5,902.18	1,413,657.78	3,312,395.31	
Point 5				0.00	2,646.51	-10,274.27	1,413,602.18	3,308,023.38	
Wells Ranch AE30-65- - actual wellpath hits target center - Point	0.00	0.00	0.00	0.00	0.00	1,410,955.76	3,318,297.27	40.455840	-104.356170
Wells Ranch AE30-65- - actual wellpath misses target center by 5.08usft at 11987.00usft MD (6599.67 TVD, 157.60 N, -5809.54 E) - Point	0.00	0.00	6,600.29	162.56	-5,810.46	1,411,118.32	3,312,487.03	40.456490	-104.377040

---

Design Report for Wells Ranch AE30-65-1HNC - Final Surveys

---

Directional Difficulty Index

Average Dogleg over Survey:	1.98 °/100usft	Maximum Dogleg over Survey:	18.59 °/100usft at 6,660.00 usft
Net Tortosity applicable to Plans:	1.06 °/100usft	Directional Difficulty Index:	6.414

Audit Info



## North Reference Sheet for Sec. 29-T6N-R62W (Wells Ranch AE29-32-A PAD) - Wells Ranch AE30-65-1HNC

All data is in US Feet unless otherwise stated. Directions and Coordinates are relative to Grid North Reference.

Vertical Depths are relative to RKB=30ft @ 4787.00usft (H&P 321). Northing and Easting are relative to Wells Ranch AE30-65-1HNC

Coordinate System is US State Plane 1983, Colorado Northern Zone using datum North American Datum 1983, ellipsoid GRS 1980

Projection method is Lambert Conformal Conic (2 parallel)

Central Meridian is -105.500000°, Longitude Origin:0.000000°, Latitude Origin:40.783333°

False Easting: 3,000,000.00usft, False Northing: 1,000,000.00usft, Scale Reduction: 0.99996324

Grid Coordinates of Well: 1,410,955.76 usft N, 3,318,297.27 usft E

Geographical Coordinates of Well: 40° 27' 21.02" N, 104° 21' 22.21" W

Grid Convergence at Surface is: 0.74°

Based upon Minimum Curvature type calculations, at a Measured Depth of 11,987.00usft

the Bottom Hole Displacement is 5,811.67usft in the Direction of 271.55° (Grid).

Magnetic Convergence at surface is: -7.57° (12 April 2014, , BGGM2013)

