


**Wellbore Diagram after P&A**

State 1-12  
SW NE 12-T2S-R44W  
Yuma County, Colorado  
K.B. = 3654'

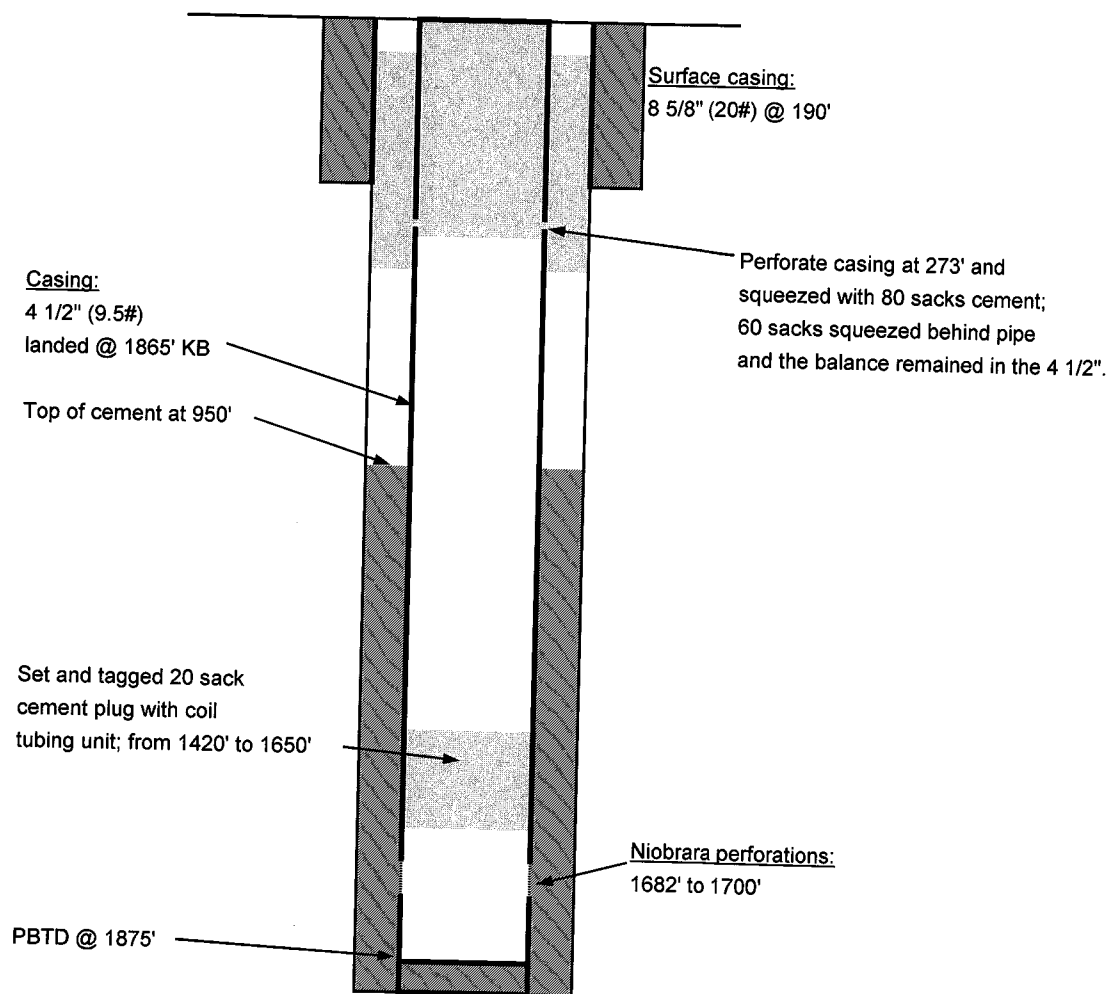

*Not to scale*  
*All depths based on measurement from KB*