

EE3 LLC


Well location, GRIZZLY #3-32H, located as shown in the NE1/4NW1/4 of Section 32, T8N, R80W, 6th P.M., Jackson County, Colorado.

BASIS OF BEARINGS


BASIS OF BEARINGS IS TRUE NORTH USING GPS

BASIS OF ELEVATION

SPOT ELEVATION AT THE NW CORNER OF SECTION 32, T8N, R80W, 6TH PM, TAKEN FROM THE COALMONT QUADRANGLE, USGS 7.5 MIN QUAD (TOPOGRAPHIC MAP) WITH SAID ELEVATION MARKED AS BEING 8074 FEET.

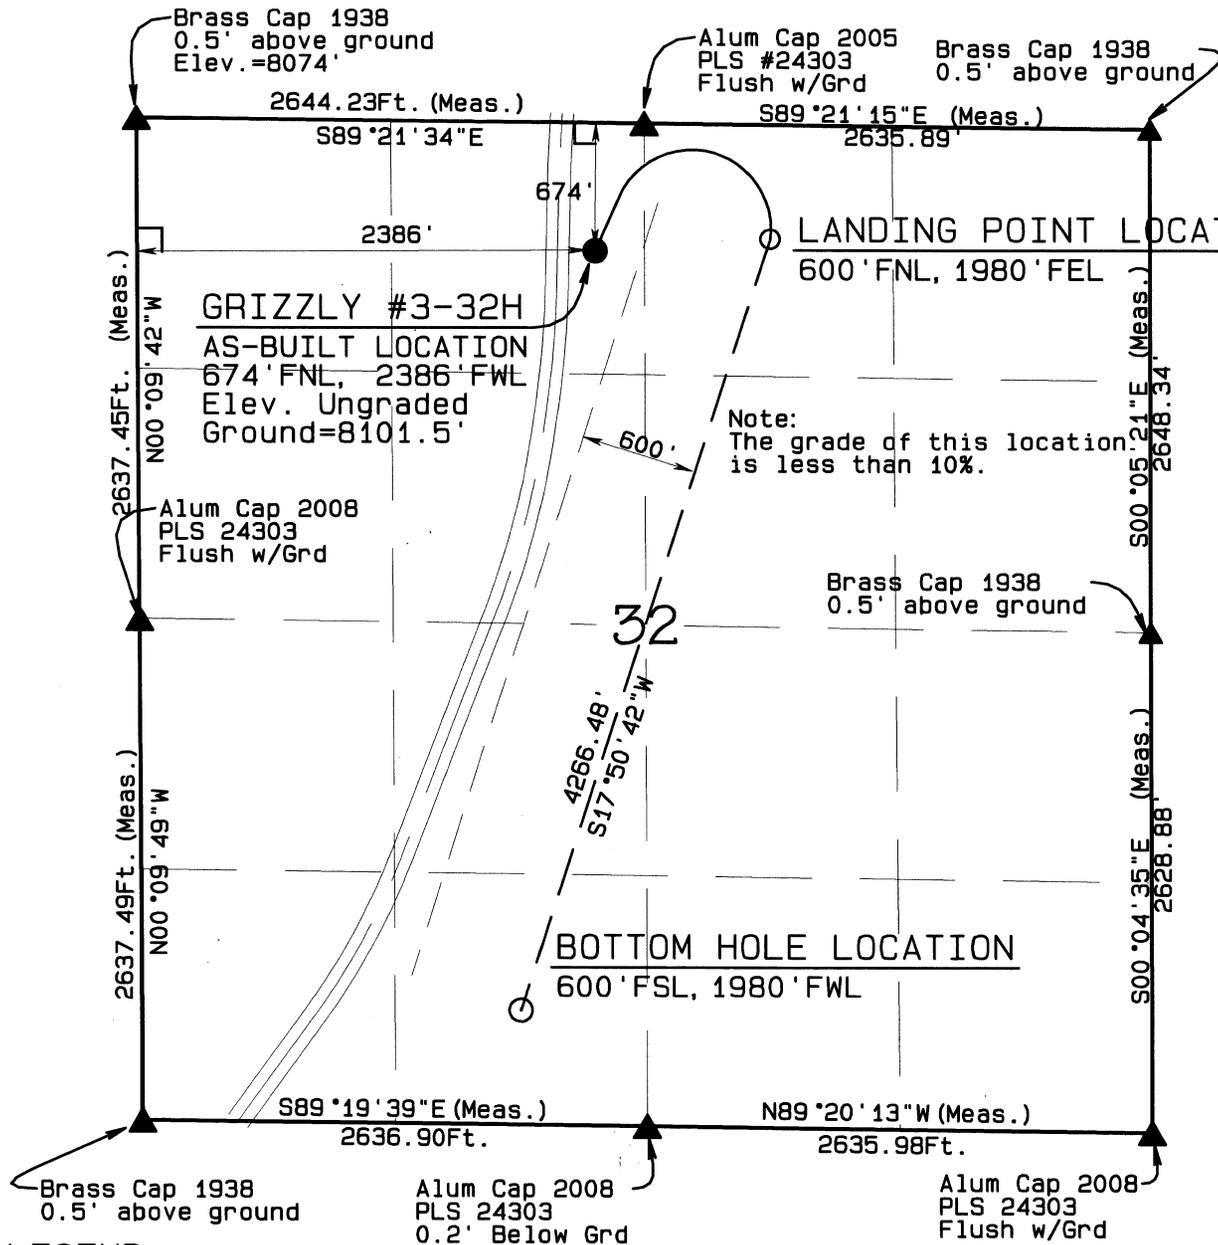

GRAPHIC SCALE 1"=1000'

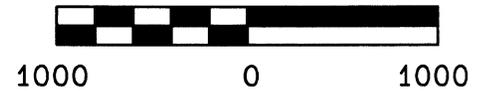

I RANDALL R. MILLER, BEING A REGISTERED LAND SURVEYOR IN THE STATE OF COLORADO, DO HEREBY CERTIFY THAT THIS MAP WAS MADE BY ME AND/OR UNDER MY DIRECT SUPERVISION AND IT IS ACCURATE TO THE BEST OF MY KNOWLEDGE.

DATED THIS _____ DAY OF _____

RANDALL R. MILLER, COLORADO PLS NO. 38084



LEGEND

90° SYMBOL
FOUND CORNER
PROPOSED WELL
BHL/LPL



NAD 83 (TARGET BOTTOM HOLE)	NAD 83 (SURFACE LOCATION)
LATITUDE=40.616811°N LONGITUDE=106.399167°W	LATITUDE=40.627795°N LONGITUDE=106.397892°W
NAD 83 (LANDING POINT)	PDOP = 1.557
LATITUDE=40.627994°N LONGITUDE=106.394605°W	

NORTH PARK ENGINEERING & CONSULTING, INC.

P.O. BOX 395
WALDEN, CO 80480
(970) 723-3725

DATE OF FIELD WORK: AUG 22, 2014 DRAWING COMPLETION: AUG 22, 2014

SURVEYED BY: DJM DRAWN BY: RRM CHECKED BY: RRM

SHEET 1 OF 1

JOB NO.: 13-029