


After Replug Schematic:

8-5/8" 20# Surface  
Set @ 202' MD

7-7/8" OH  
To 6575' MD

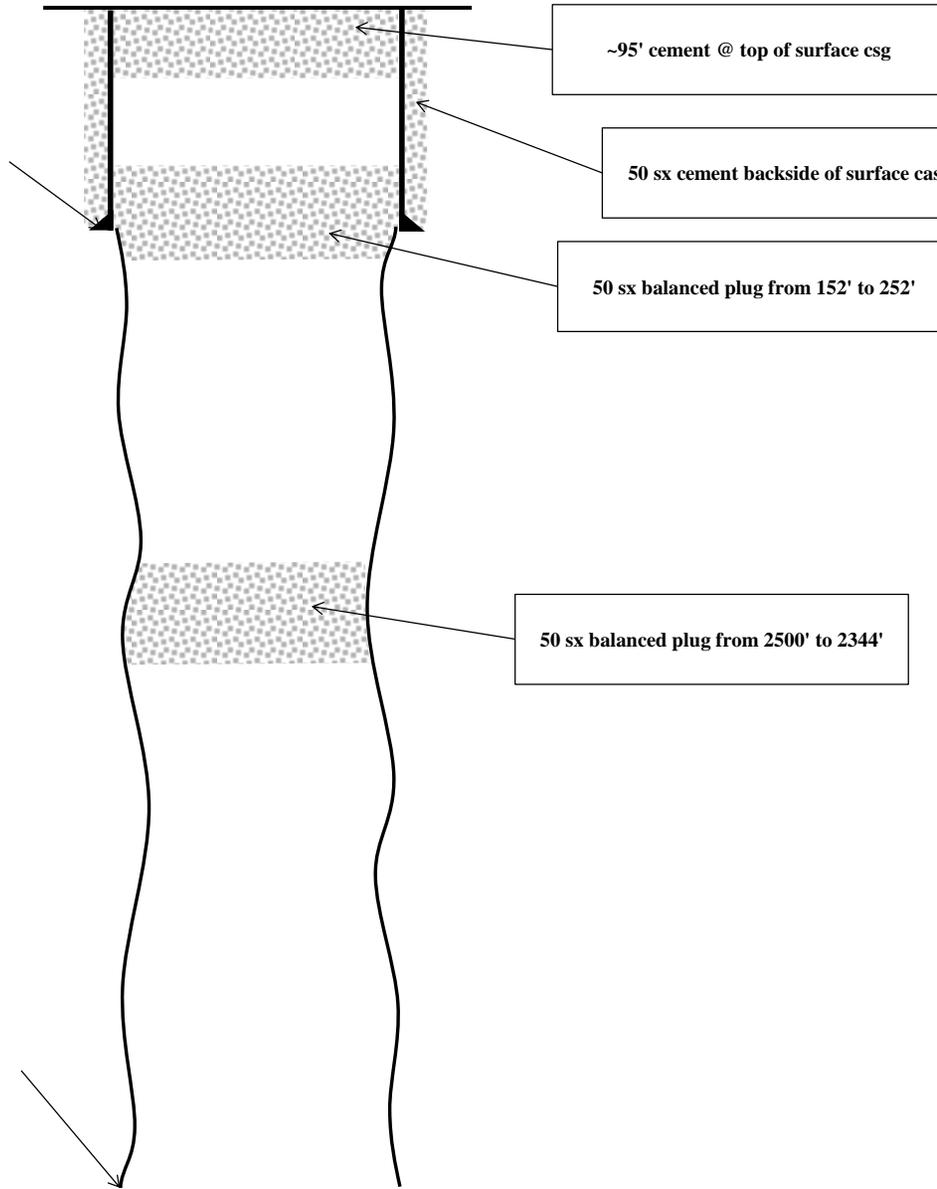

~95' cement @ top of surface csg

50 sx cement backside of surface casing

50 sx balanced plug from 152' to 252'

50 sx balanced plug from 2500' to 2344'