


After Replug Schematic:

8-5/8" 24# Surface  
Set @ 126' MD

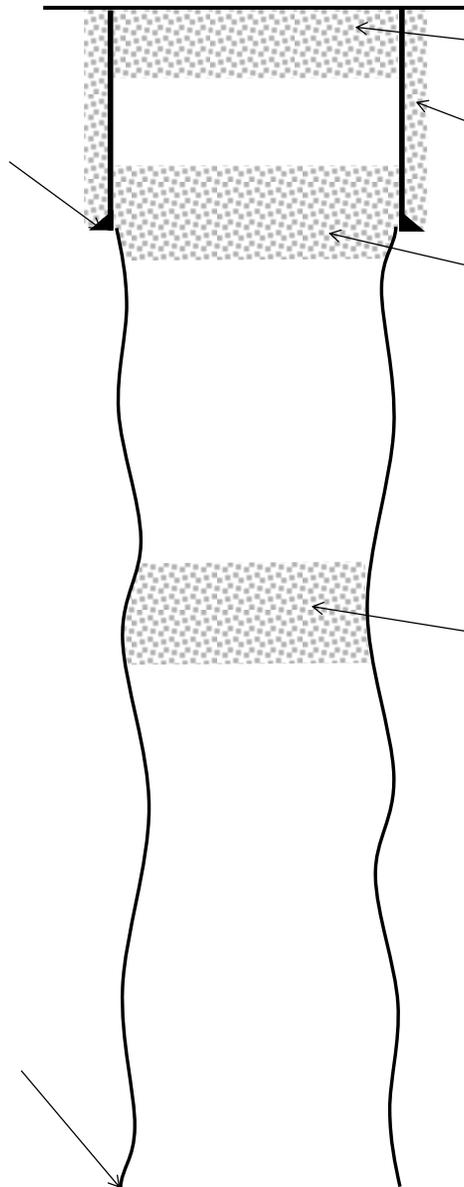

~95' cement @ top of surface csg

50 sx cement backside of surface casing

50 sx balanced plug from 76' to 176'

50 sx balanced plug from 2500' to 2344'

7-7/8" OH  
To 6495' MD