

Cary Walking Unit A #1

General Location:


Nenw-21-2N-66W

Latitude/Longitude: N40.12905000, W -104.78529000:

County: Weld, State: CO

Spud Date: 11/13/1979

Total Depth: 4800

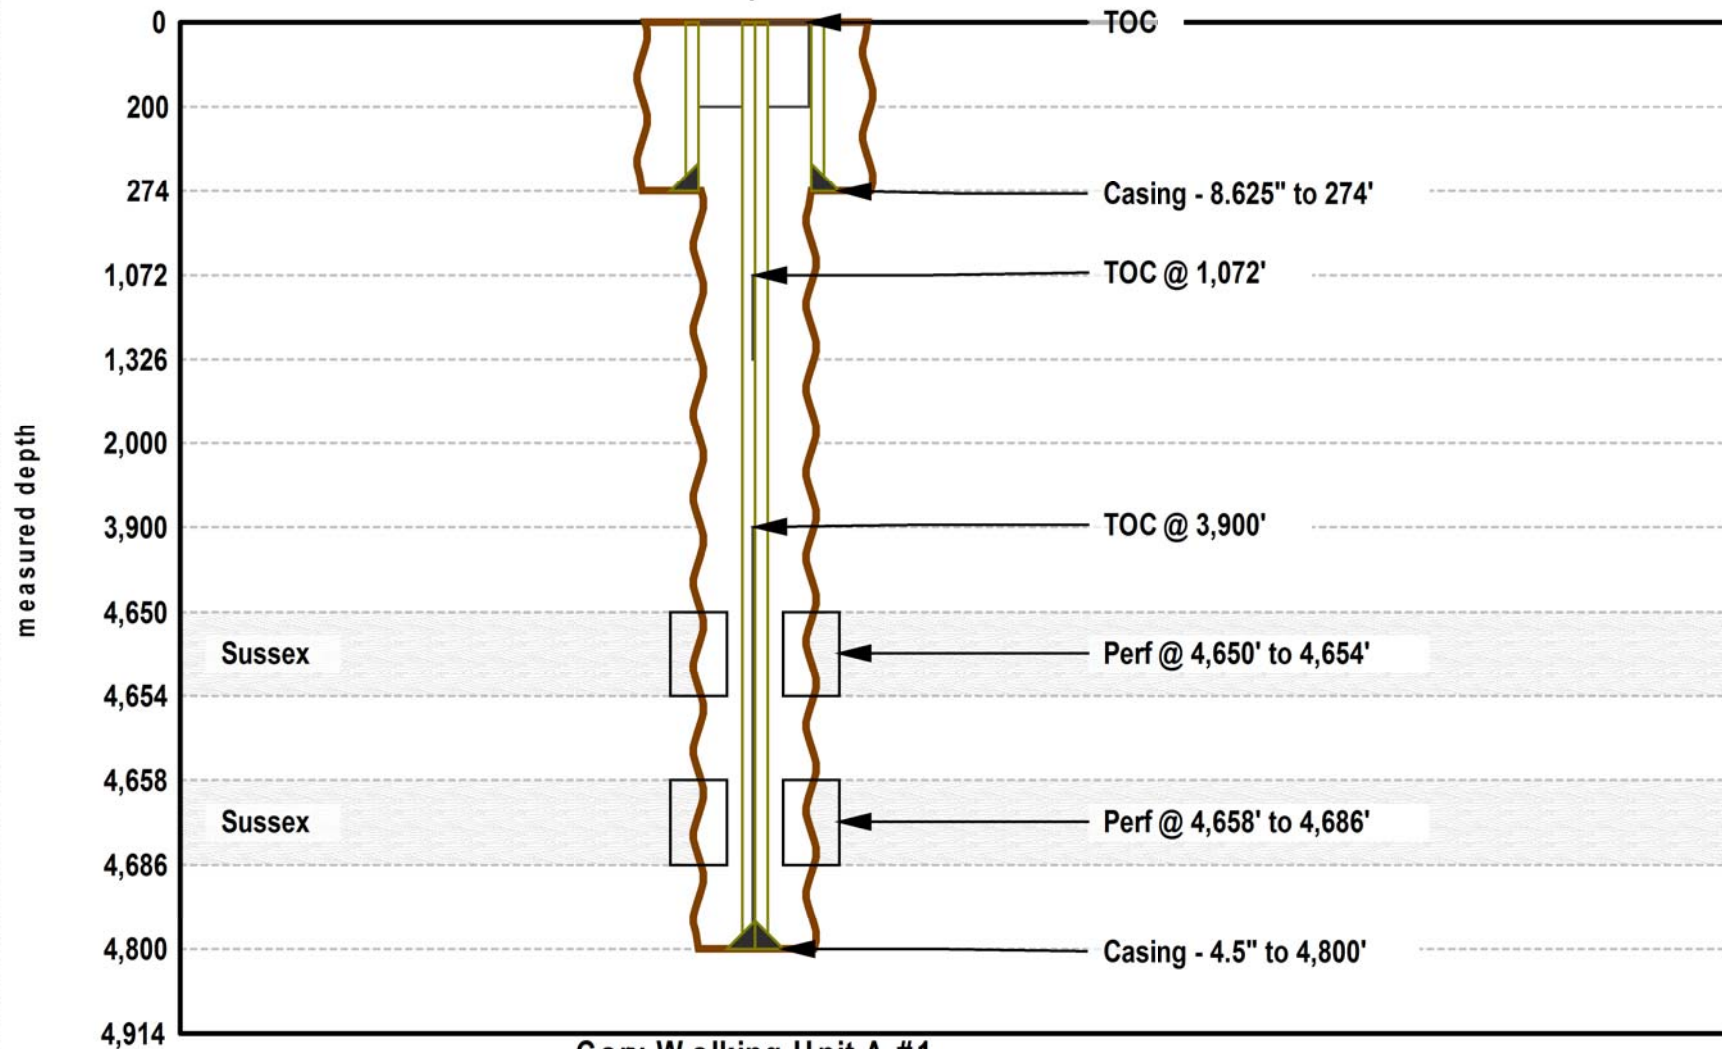

Cary Walking Unit A #1

Initial Completion: 1/29/1980

Proposed Depth: 4800 Plug Back Depth: 4749