


Directional Survey Plan View
Well: Caddell #2


Operator Name: TABULA RASA ENERGY, LLC
Operator Number: 10467
Well Name and Number: CADDELL #2
API Number (if available): 05-055-06312-00
Location: QQ SEC TWP RGE: Sec 4, T29S, R 69W
Citing Type: Planned or Actual: actual

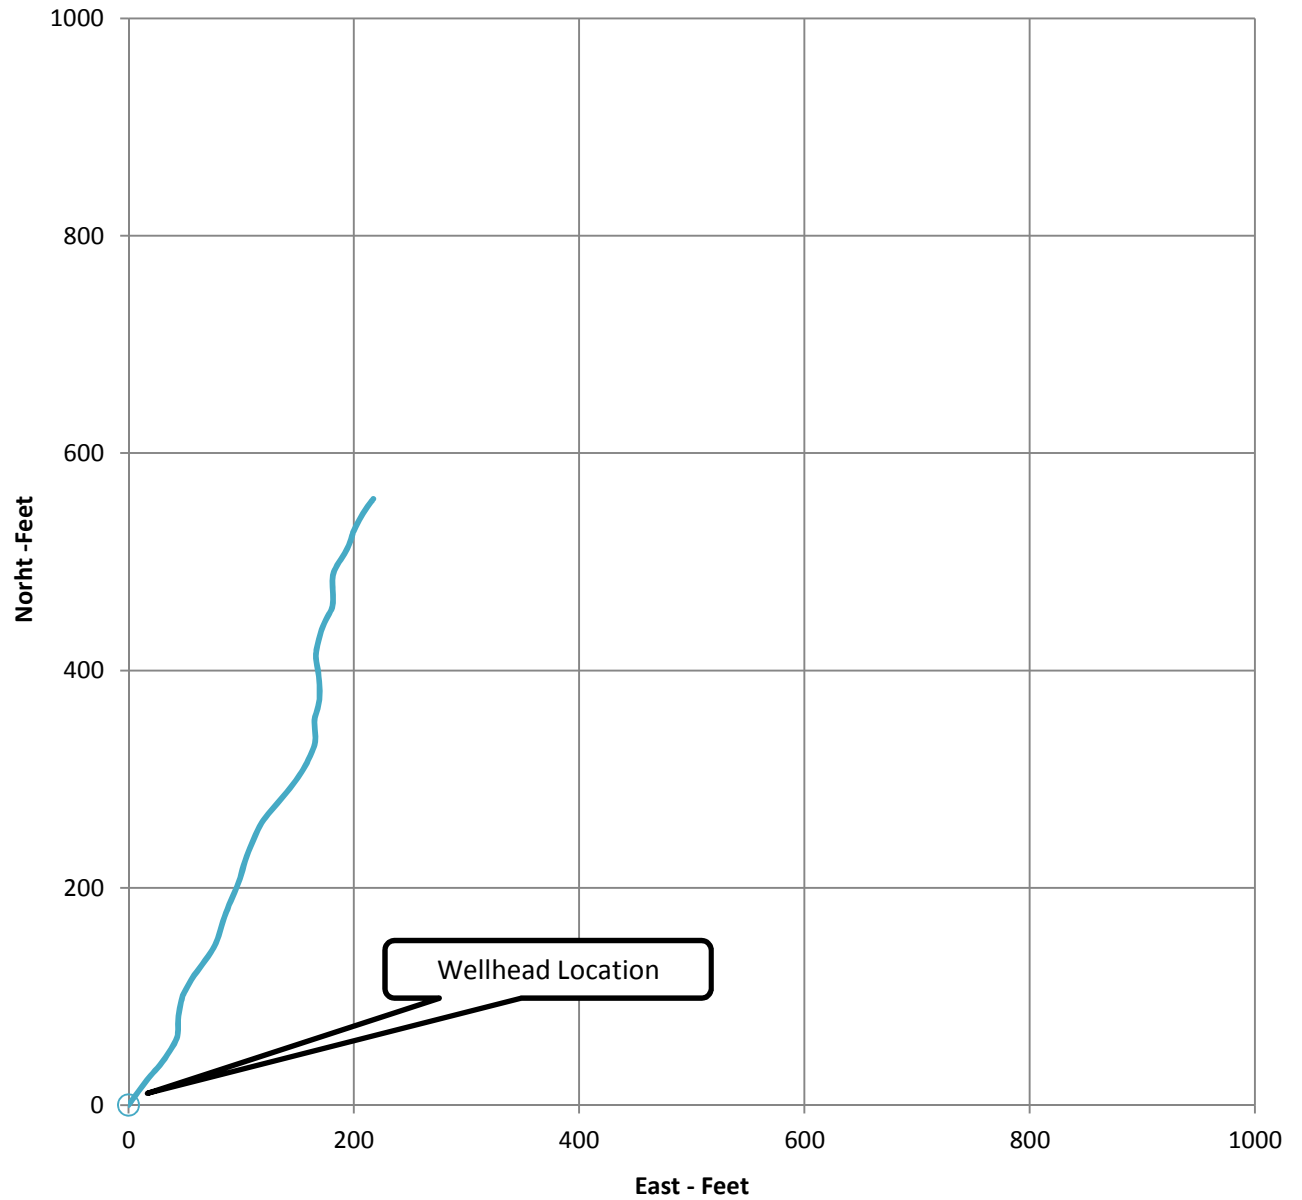

Directional Survey North- South Cross Section

Well: Caddell #2

Operator Name: TABULA RASA ENERGY, LLC
Operator Number: 10467
Well Name and Number: CADDELL #2
API Number (if available): 05-055-06312-00
Location: QQ SEC TWP RGE: Sec 4, T29S, R 69W
Citing Type: Planned or Actual: actual

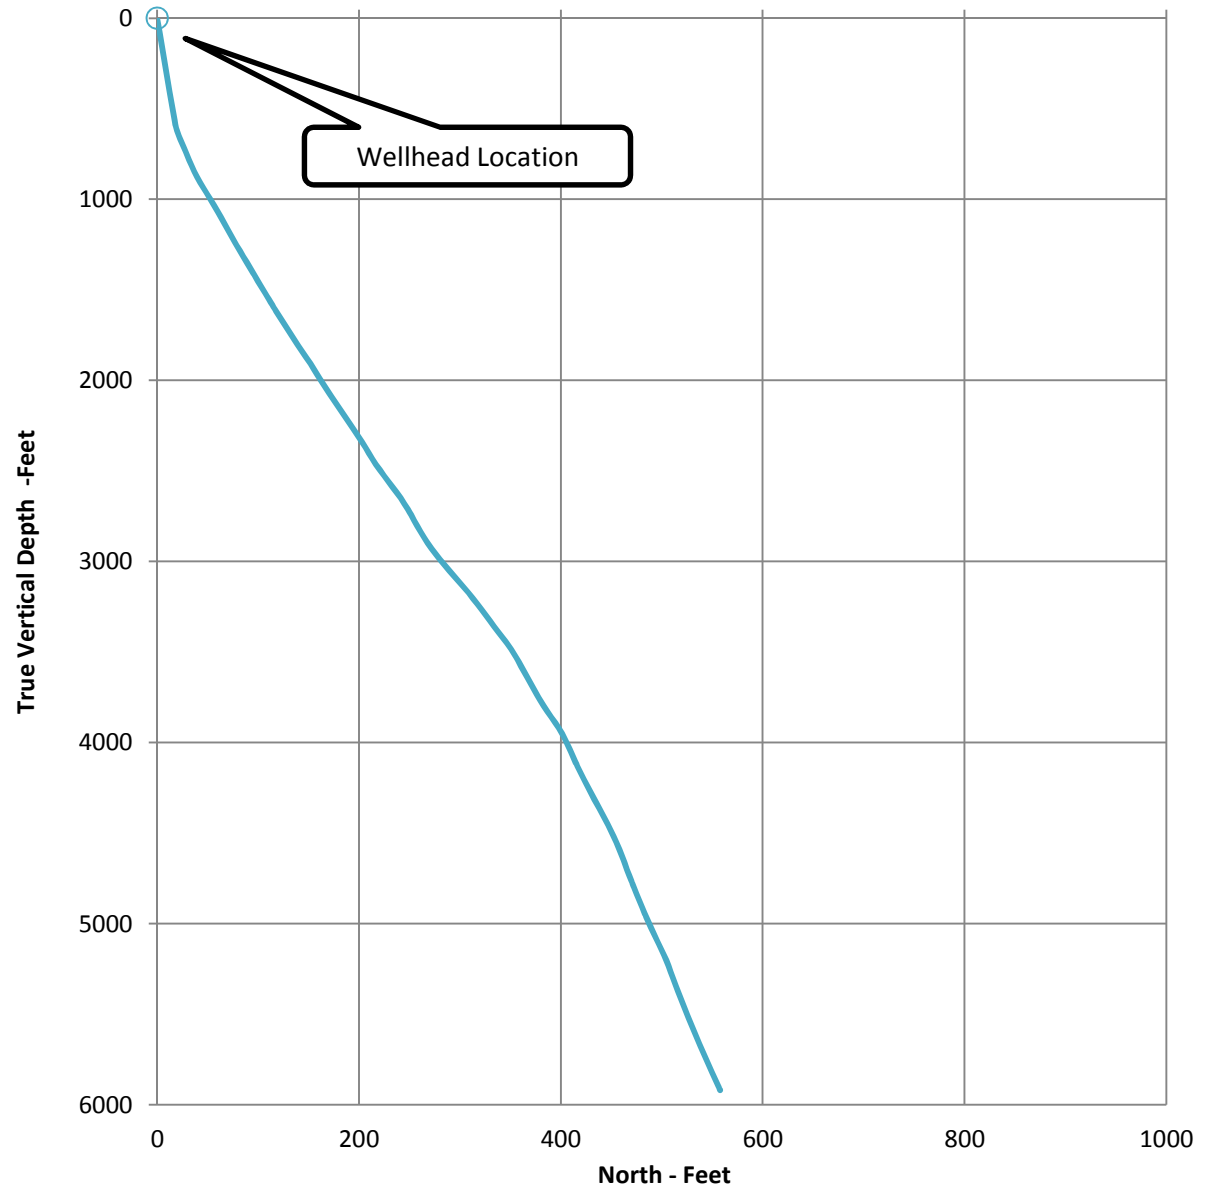

Directional Survey East-West Cross Section
Well: Caddell #2

Operator Name: TABULA RASA ENERGY, LLC
Operator Number: 10467
Well Name and Number: CADDELL #2
API Number (if available): 05-055-06312-00
Location: QQ SEC TWP RGE: Sec 4, T29S, R 69W
Citing Type: Planned or Actual: actual

