

WELLBORE DIAGRAM


Bayswater E & P MSH Farms 13-15

SWSW Sec 15-T7N-R67W
SHL: 205' FSL, 1026' FWL
BHL: 719' FSL, 578' FWL
Weld County CO
05-123-37590

Directions: WCR 80 at WCR 23, 1.75 mi W, N side

West well head of two

Updated
11/23/2013
SMS

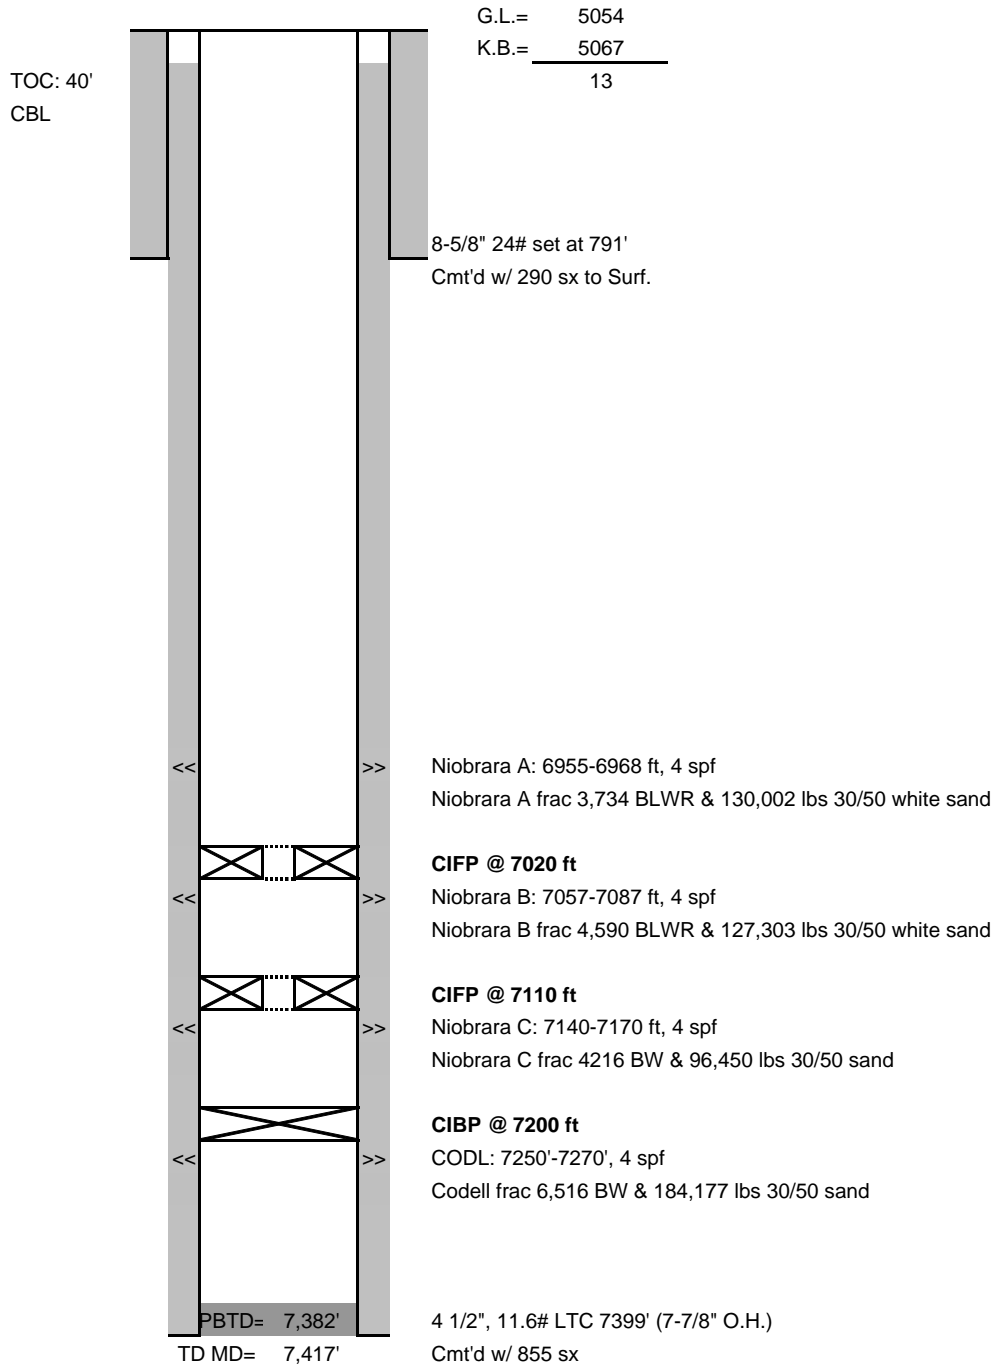

TD VD= 7,362'