


Well Name: DOMENICO MC33-16X

VERTICAL - ORIGINAL HOLE, 10/14/2014 9:52:34 AM

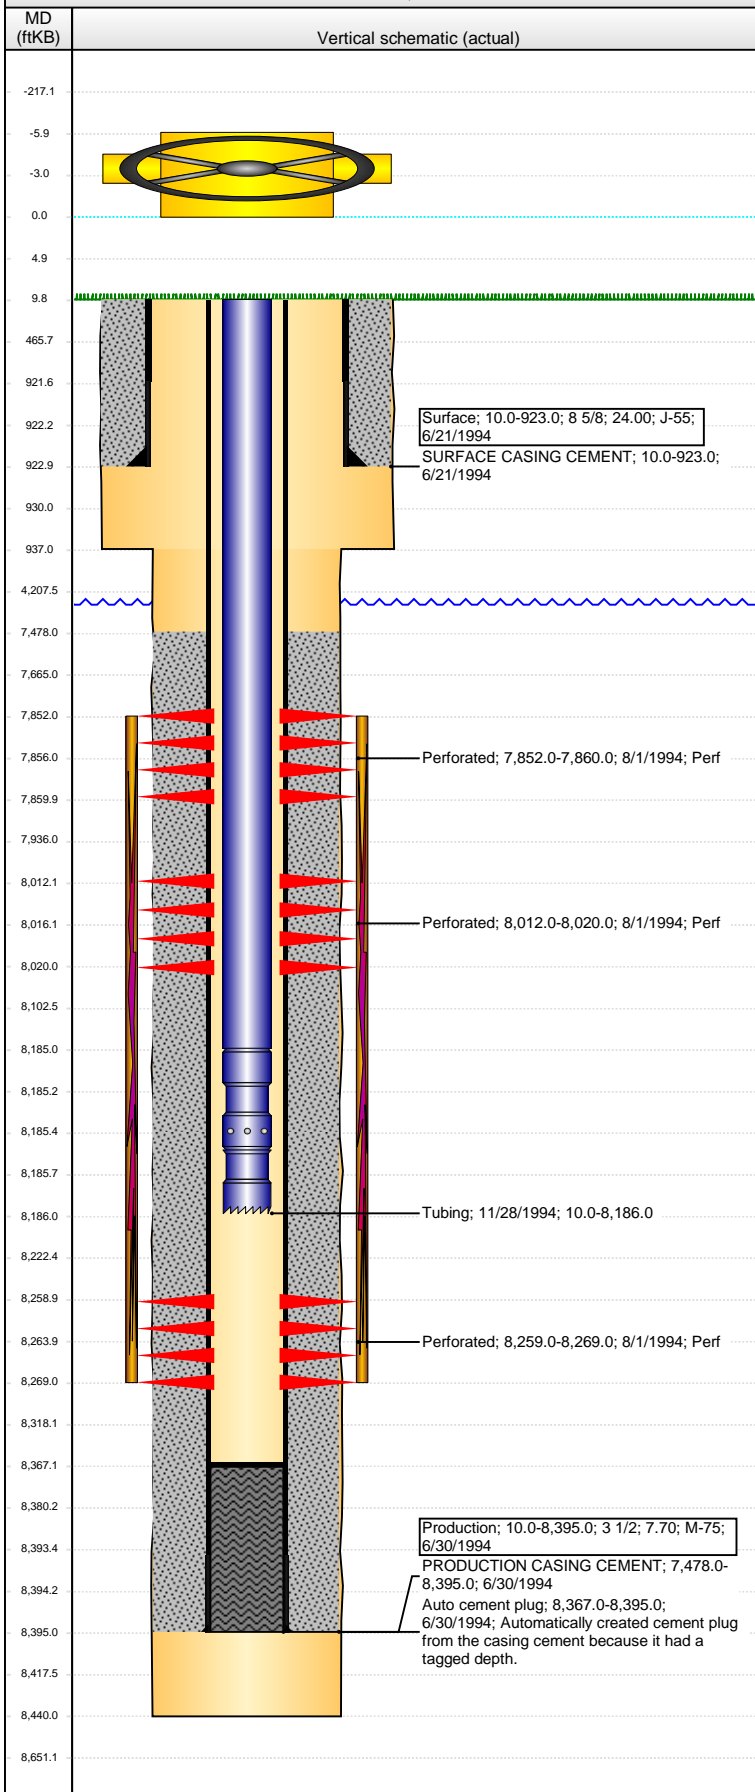

Well Header

API	Business Unit	District	Well Config
05-013-06466	DJ BASIN	15	VERTICAL
Original KB Elevation (ft)	KB - GL / MSL (ftKB)	Spud Date	P & A Date
5,368.00	10.00	6/20/1994	
Comment			

Directions To Well

Congressional Location

Quarter 1	Quarter 2	Quarter 3	Quarter 4	Section	Township	Twtnshp N...	Range	Rng E/W Dir
		SE	SE	33	1	N	69	W

Bottom Hole Location

North-South Distance (ft)	From N or S Line	East-West Distance (ft)	From E or W Line

Plug Back Total Depths

Date	Depth (ftKB)	Method	Com
7/1/1994	8,367.0	TAG	GUIDE SHOE
8/1/1994	8,367.0	CASED HOLE LOG	DEPTH LOGGER

Wellbore Sections

Section Des	Size (in)	Act Top, MD (ftKB)	Act Btm, MD (ftKB)
SURFACE	12 1/4	10.0	937.0
PRODUCTION	7 7/8	937.0	8,440.0

Zone Statuses

Zone Name	Status Date	Status	Job
NIOBRARA-CODELL	9/16/1994	PR	DRILLING/COMPLETION - ORIGINAL, 6/20/1994 00:00
CODELL	9/16/1994	PR	DRILLING/COMPLETION - ORIGINAL, 6/20/1994 00:00
NIOBRARA	9/16/1994	PR	DRILLING/COMPLETION - ORIGINAL, 6/20/1994 00:00

Casing Strings

Casing Description	Run Date	OD (in)	Wt/Len (l...)	Grade	Top, MD (ft...)	MD (ftKB)
Surface	6/21/1994	8 5/8	24.00	J-55	10.0	923.0

Production, 8,395.0ftKB

Casing Description	Run Date	OD (in)	Wt/Len (l...)	Grade	Top, MD (ft...)	MD (ftKB)
Production	6/30/1994	3 1/2	7.70	M-75	10.0	8,395.0

Cement

Description	Top Depth (ftKB)	Bottom Depth (ftKB)
SURFACE CASING CEMENT	10.0	923.0
Description	Top Depth (ftKB)	Bottom Depth (ftKB)
PRODUCTION CASING CEMENT	7,478.0	8,395.0

Tubing Components

Item Des	OD (in)	Wt (lb/ft)	Grade	Jts	Len (ft)	Btm (ftKB)	Btm (TVD) (ftKB)
Tubing	2 1/16	3.25	J-55	260	8,175.00	8,185.0	
Seal Nipple	2 1/16			1	0.50	8,185.5	
Notched collar	2 1/16			1	0.50	8,186.0	

Perforation Data

Zone	Bnch/St g	Entered Shot Total	Top (ftKB)	Btm (ftKB)	Date
NIOBRARA, ORIGINAL HOLE	A	3	7,852.00	7,860.00	8/1/1994
NIOBRARA, ORIGINAL HOLE	B	3	8,012.00	8,020.00	8/1/1994
CODELL, ORIGINAL HOLE		7	8,259.00	8,269.00	8/1/1994

Stimulations & Treatments

Date	Zone	Primary Job Type
8/3/1994	NIOBRARA-CODELL, ORIGINAL HOLE	DRILLING/COMPLETION - ORIGINAL
Technical Result	Tech Result Details	Tech Result Note

Comment

C/N LIMITED ENTRY

Other In Hole

Run Date	Des	OD (in)	Top (ftKB)	Btm (ftKB)

Logs

Date	Type	Top, MD (ftKB)	Btm, MD (ftKB)
6/30/1994	COMPENSATED DENSITY	7,400.0	8,430.0
6/30/1994	INDUCTION	7,400.0	8,430.0

Well Name: DOMENICO MC33-16X

VERTICAL - ORIGINAL HOLE, 10/14/2014 9:52:37 AM

Logs

