




Lease Name: Brownwood #11-2

Legals: NESW – Sec. 11, T4N, R67W

County: Weld County, Colorado

API#: 05-123-13882

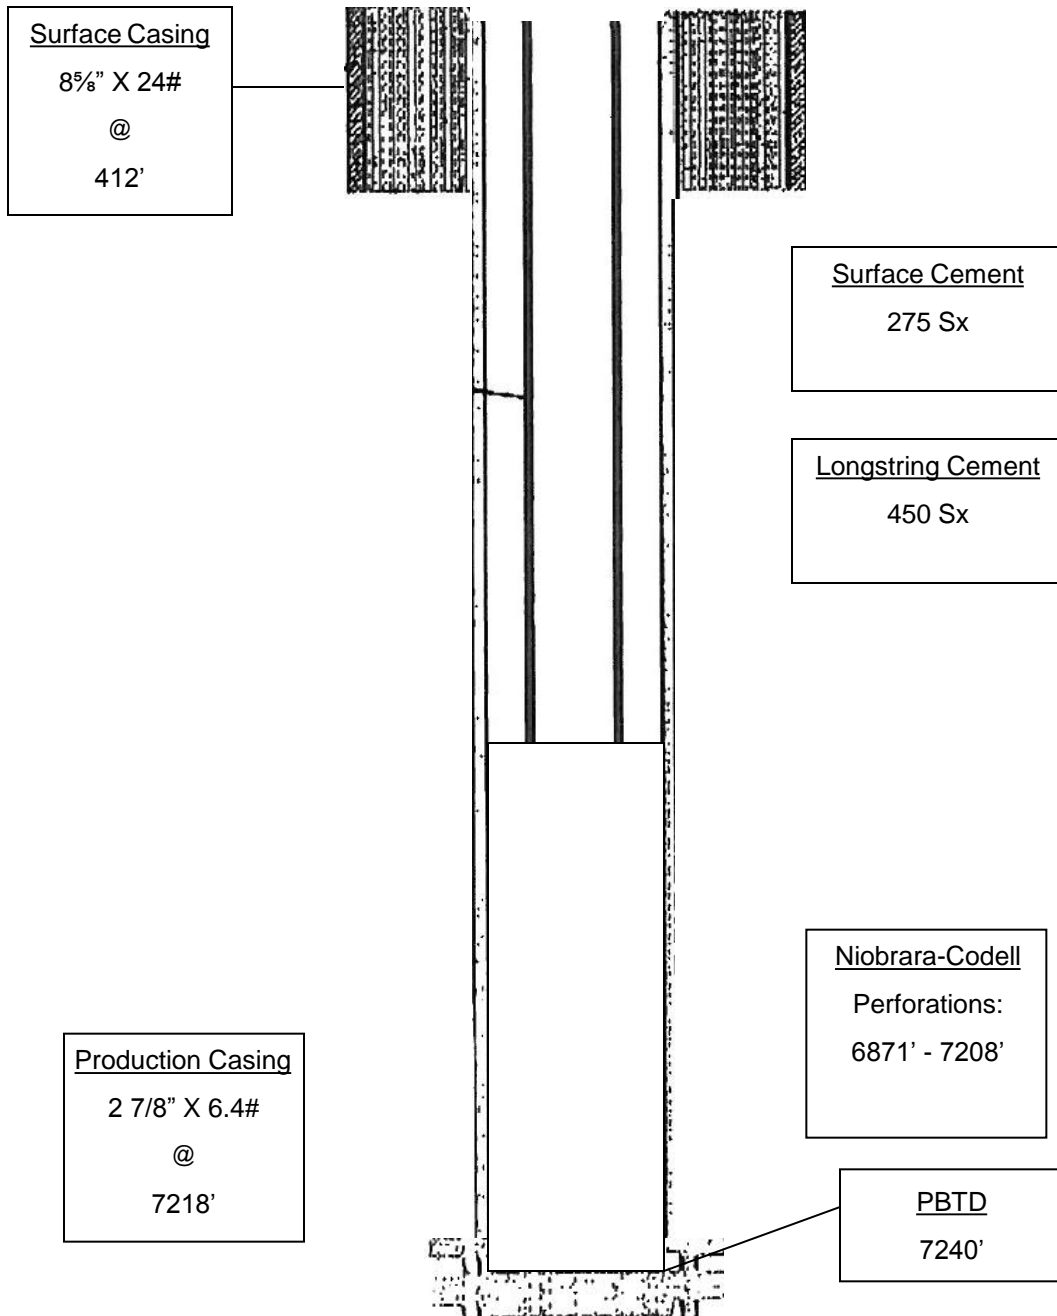

Wellbore Diagram