


KING SURVEYORS 650 E. GARDEN DR. WINDSOR, CO 80550  
**WELL LOCATION CERTIFICATE**


EWS 1A

SECTION: 26  
 TOWNSHIP: 8N  
 RANGE: 60W

THIS MAP DOES NOT REPRESENT A BOUNDARY SURVEY

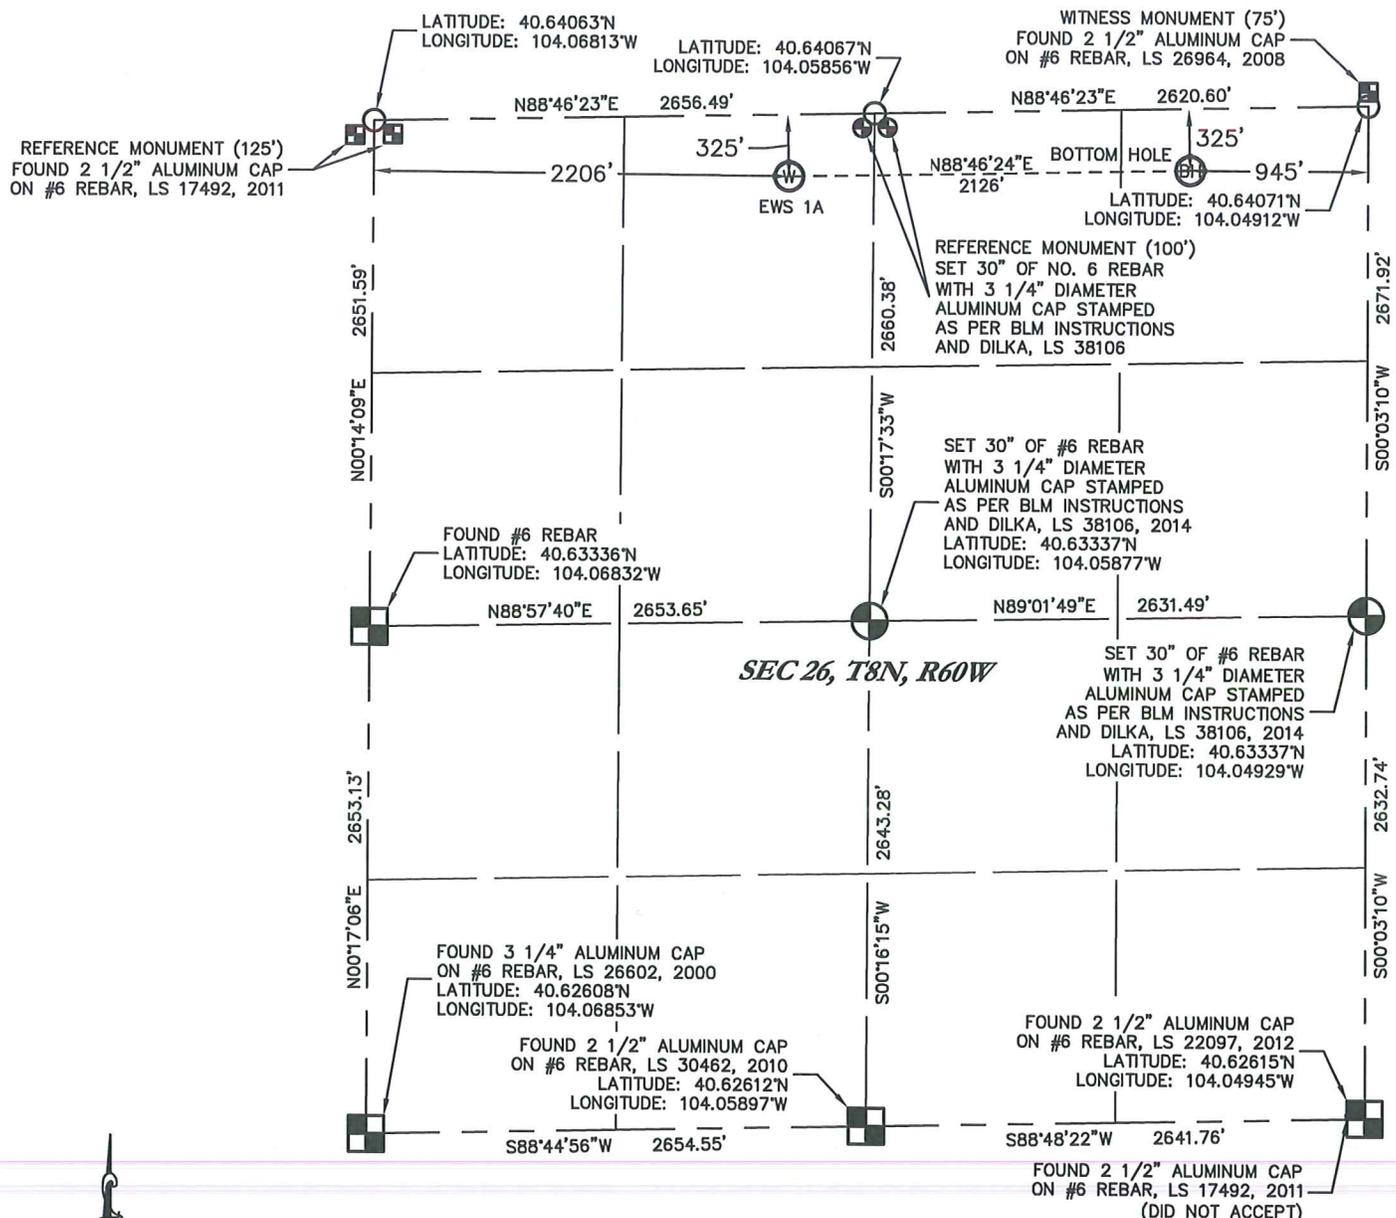

**SEC 26, T8N, R60W**

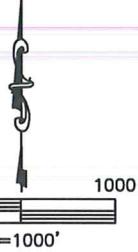

In accordance with a request from Jim Goddard for EXPEDITION WATER SOLUTIONS, King Surveyors has determined the surface location of EWS 1A to be 325' from the NORTH line and 2206' from the WEST line and the bottom hole location to be 325' from the NORTH line and 945' from the East line, as measured at right angles, from the section lines of Section 26, Township 8 North, Range 60 West of the Sixth Principal Meridian, County of Weld, State of Colorado.

I hereby state that this Well Location Certificate was prepared by me, or under my direct supervision, that the fieldwork was completed on 10-9-2014, for and on behalf of EXPEDITION WATER SOLUTIONS, that this is not a Land Survey Plat or an Improvement Survey Plat, and that it is not to be relied upon for establishment of fence, building, or other future Improvement lines.

- NOTES:
- 1) Bearings shown are Grid Bearings of the Colorado State Plane Coordinate System, North Zone, North American Datum 1983. The lineal dimensions as contained herein are based upon the "U.S. Survey Foot."
  - 2) Ground elevations are based on an observed GPS elevation (NAVD 1988 DATUM).
  - 3) IMPROVEMENTS: See LOCATION DRAWING for all visible improvements within 500' of the disturbed area.
  - 4) SURFACE USE: PASTURE/PRAIRIE
  - 5) INSTRUMENT OPERATOR: TYSON SNYDER
  - 6) NEAREST CULTURAL ITEMS:  
 BUILDING: 4500' SW  
 BUILDING UNIT: 5280'+  
 HIGH OCCUPANCY BUILDING UNIT: 5280'+  
 DESIGNATED OUTDOOR ACTIVITY AREA: 5280'+  
 PUBLIC ROAD: 307' NORTH  
 ABOVE GROUND UTILITY: 2237' WEST  
 RAILROAD: 5280'+ NE  
 PROPERTY LINE: 250' NORTH

**LEGEND**

- = FOUND ALIQUOT MONUMENT AS DESCRIBED
- = CALCULATED POSITION
- = SET ALIQUOT MONUMENT AS DESCRIBED



**SURFACE LOCATION**  
 LATITUDE: 40.63977°N  
 LONGITUDE: 104.06020°W  
 PDOP: 1.4  
 ELEV: 4907'  
 1/4, 1/4: NE1/4 NW1/4

**BOTTOM HOLE**  
 LATITUDE: 40.63980°N  
 LONGITUDE: 104.05255°W  
 1/4, 1/4: NE1/4 NE1/4

Michael Chad Dilka On Behalf Of King Surveyors  
 Colorado Licensed Professional Land Surveyor #38106