

KERR-MCGEE OIL AND GAS ONSHORE LP

WARDELL UPRR 31-29 3

NW NE 29 3N 65W -- --

WELD,COLORADO

10/15/2014

AREA: E1

ROUTE: E15 Spud: 02/20/1988

WINS No.: 76939

AFE/WO#: 2101876

API#: 0512313795

GL: 4885

KB: 4896

MTD: 7165

TVD: 7165


LOG MD:

PBMD: 7308

PBTVD: 7308

Directions:

**WCR 30 & WCR 39, S 1/2, E THRU YELLOW GATE @ AMOCO TANK, RD Y'S, STAY E, S INTO BEHIND
HORIZONTAL TANK, CLOSE GATE**

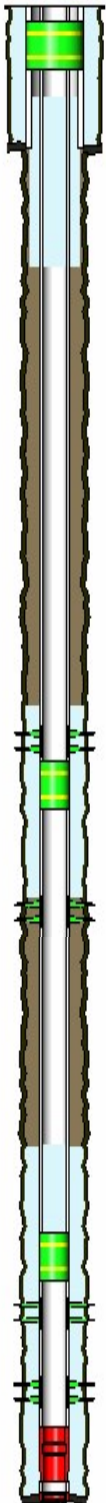

<u>HOLE SECTIONS</u>	<u>Size</u>	<u>Top</u>	<u>Btm</u>	<u>TD Date</u>				
SURFACE	12.25	11	594	02/20/1988				
PRODUCTION	7.88	594	7356	02/26/1988				
<u>TUBULARS</u>	<u>Tool Type</u>	<u>Joints</u>	<u>Size</u>	<u>Weight</u>	<u>Grade</u>	<u>Thread</u>	<u>Top D</u>	<u>Bottom D</u>
SURFACE CASING	Casing	14	8.63	24			11	594
PRODUCTION CASING	Casing	175	4.50	15.10			11	7312
	Casing Float Collar	1	4.50				7312	7313
	Casing	1	4.50	15.10			7313	7355
	Casing Guide Shoe	1	4.50				7355	7356
BRIDGE PLUG	Cast Iron Bridge Plu	1	4.50				6900	6901
BRIDGE PLUG	Cement Retainer	1	4.50				4360	4361
BRIDGE PLUG	Cast Iron Bridge Plu	1	8.63				80	82
<u>CEMENT JOBS</u>	<u>Stage</u>	<u>Sacks</u>	<u>Cement Jobs</u>			<u>Top D</u>	<u>Btm D</u>	<u>cbl</u>
SURFACE CASING	STAGE 1	380		G		11	594	No
PRODUCTION CASING	PRIM CMT 1ST STAGE	250	LEAD			6340	7356	No
PRODUCTION CASING	ABANDONMENT PLUC	30	LEAD	FRESH WATER		6337	6900	No
PRODUCTION CASING	ABANDONMENT PLUC	470	LEAD	FRESH WATER		4200	4930	No
SURFACE CASING	ABANDONMENT PLUC	520	LEAD	FRESH WATER		260	1360	No
<u>PERFORATIONS</u>	<u>Formation</u>	<u>Zone</u>	<u>Top</u>	<u>Btm</u>	<u>Date</u>	<u>Reason</u>	<u>Comments</u>	
			4330	4331	09/16/2014	CEMENT SQUEEZE		
			4930	4931	09/16/2014	CEMENT SQUEEZE		
NIOBRARA			6986	7054	03/14/1988	PRODUCTION		
CODELL			7240	7250	03/09/1988	PRODUCTION		

Comments: