

WPX Energy Rocky Mountain LLC

SAVAGE RWF 543-25


RULISON Field

SHL: 1162' FSL 1381' FEL (SW/4 SE/4) Section 25 T6S R94W 6th PM

BHL: 1870' FSL 674' FeL (NE/4 SE/4) Section 25 T6S R94W 6th PM

Garfield County Colorado

Formation Tops
(Measured Depths)

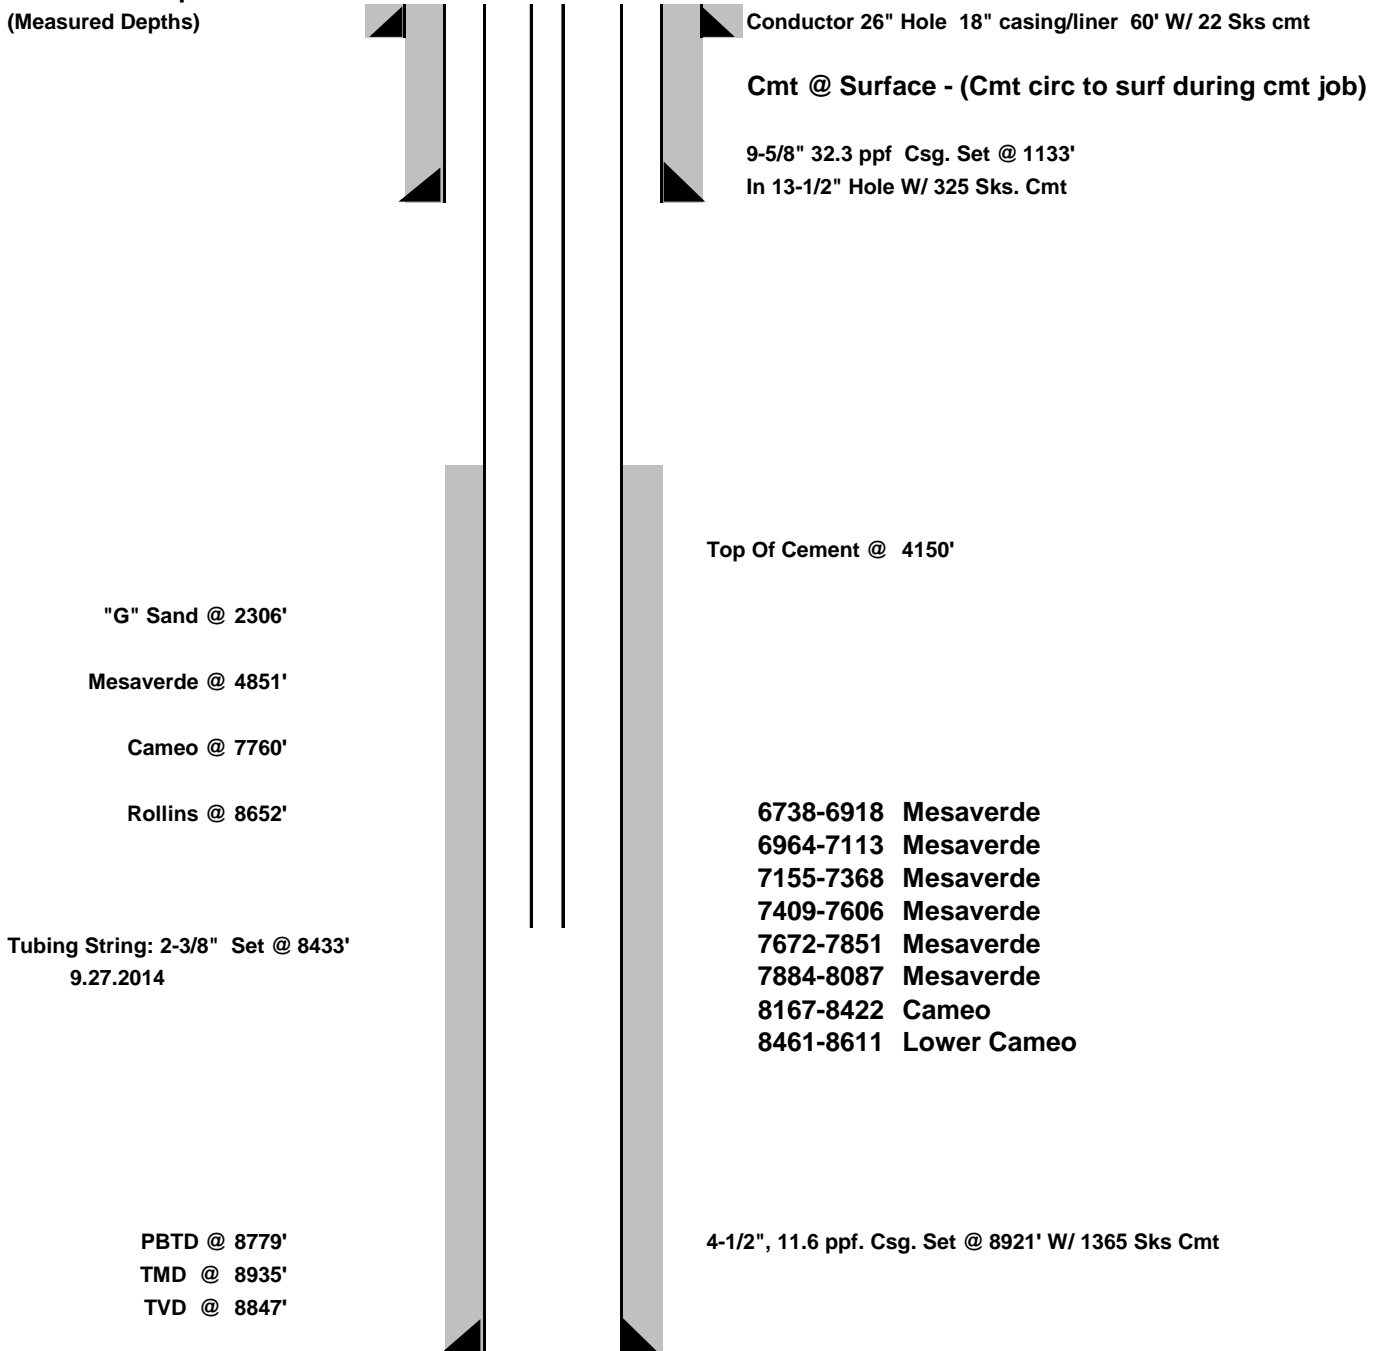

DATE CREATED: 10.8.2014

NOTE: THIS IS NOT TO SCALE.
****FINAL****