

KERR-MCGEE OIL AND GAS ONSHORE LP

HSR-BRINTON 14-10A

SE SW 10 3N 66W -- --

WELD,COLORADO

10/22/2014

AREA: N1

ROUTE: N12 Spud: 09/08/1992

WINS No.: 76850

AFE/WO#: 2100593

API#: 0512316059

GL: 4883

KB: 4893

MTD: 7962


TVD: 7962

LOG MD: 7968

PBMD: 7955

PBTVD: 7955

Directions: WCR 33 & WCR 34, W 6/10, N INTO

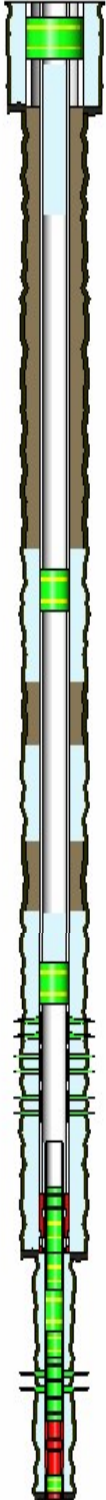

<u>HOLE SECTIONS</u>	<u>Size</u>	<u>Top</u>	<u>Btm</u>	<u>TD Date</u>			
SURFACE	12.25	10	490	09/09/1992			
PRODUCTION	7.88	490	7474	09/14/1992			
DEEPENED	3.88	7474	7962	12/28/2000			

<u>TUBULARS</u>	<u>Tool Type</u>	<u>Joints</u>	<u>Size</u>	<u>Weight</u>	<u>Grade</u>	<u>Thread</u>	<u>Top D</u>	<u>Bottom D</u>
SURFACE CASING	Casing	11	8.63	24	IPSCO		10	467
PRODUCTION CASING	Casing	167	4.50	11.6	I-70	LTC	10	7428
	Casing Float Collar	1	4.50				7428	7429
	Casing	1	4.50	11.6	I-70	LTC	7429	7463
	Casing Guide Shoe	1	4.50				7463	7464
DEEPENED LINER	Liner Hanger	1	2.88		ARROW		7408	7413
	Liner	10	2.88	6.50	N-80	8RD EUE	7413	7757
	Liner	1	2.88	6.5	N-80		7757	7763
	Liner	5	2.88	6.50	N-80	8RD EUE	7763	7935
	Casing Float Collar	1	2.88				7935	7937
	Liner	1	2.88	6.50	N-80	8RD EUE	7937	7966
	Casing Guide Shoe	1	2.88				7966	7967
BRIDGE PLUG	CIBP With CMT Cap	1	2.88				7750	7752
CAST IRON CEMENT RETAINER	Cement Retainer	1	4.50				4166	4168
BRIDGE PLUG	Cast Iron Bridge Plu	1	4.50				6974	6975
BRIDGE PLUG	Cast Iron Bridge Plu	1	8.63				80	82

<u>CEMENT JOBS</u>	<u>Stage</u>	<u>Sacks</u>	<u>Cement Jobs</u>	<u>Top D</u>	<u>Btm D</u>	<u>cbl</u>
SURFACE CASING	STAGE 1	340	NEAT	10	467	No
PRODUCTION CASING	LEAD	170	PREMIUM	5240	6000	Yes
	TAIL	145	PREMIUM	6560	7464	Yes
DEEPENED LINER	STAGE 1	35	G	7408	7962	Yes
PRODUCTION CASING	ABANDONMENT PLUC	26	LEAD FRESH WATER	6574	6974	No
PRODUCTION CASING	ABANDONMENT PLUC	264	LEAD FRESH WATER	4000	4732	No
PRODUCTION CASING	ABANDONMENT PLUC	420	LEAD FRESH WATER	130	1327	No

<u>PERFORATIONS</u>	<u>Formation</u>	<u>Zone</u>	<u>Top</u>	<u>Btm</u>	<u>Date</u>	<u>Reason</u>	<u>Comments</u>
			4130	4131	09/23/2014	CEMENT SQUEEZE	
			4732	4733	09/23/2014	CEMENT SQUEEZE	
	NIOBRARA		7047	7069	09/22/1992	PRODUCTION	
	NIOBRARA		7109	7124	09/22/1992	PRODUCTION	
	NIOBRARA		7213	7238	09/22/1992	PRODUCTION	
	J SAND		7810	7840	01/09/2001	PRODUCTION	

KERR-MCGEE OIL AND GAS ONSHORE LP

HSR-BRINTON 14-10A

SE SW 10 3N 66W -- --

WELD,COLORADO

10/22/2014

AREA: N1

ROUTE: N12

Spud: 09/08/1992

WINS No.: 76850

AFE/WO#: 2100593

API#: 0512316059

GL: 4883

KB: 4893

MTD: 7962

TVD: 7962

LOG MD: 7968

PBMD: 7955

PBTVD: 7955

Directions:

WCR 33 & WCR 34, W 6/10, N INTO

Comments: