



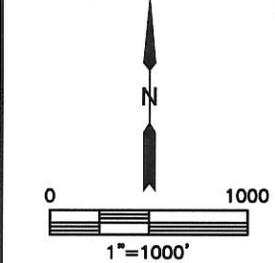

WELL LOCATION CERTIFICATE

THIS MAP DOES NOT REPRESENT A BOUNDARY SURVEY

SECTION: 25
TOWNSHIP: 9N
RANGE: 59W

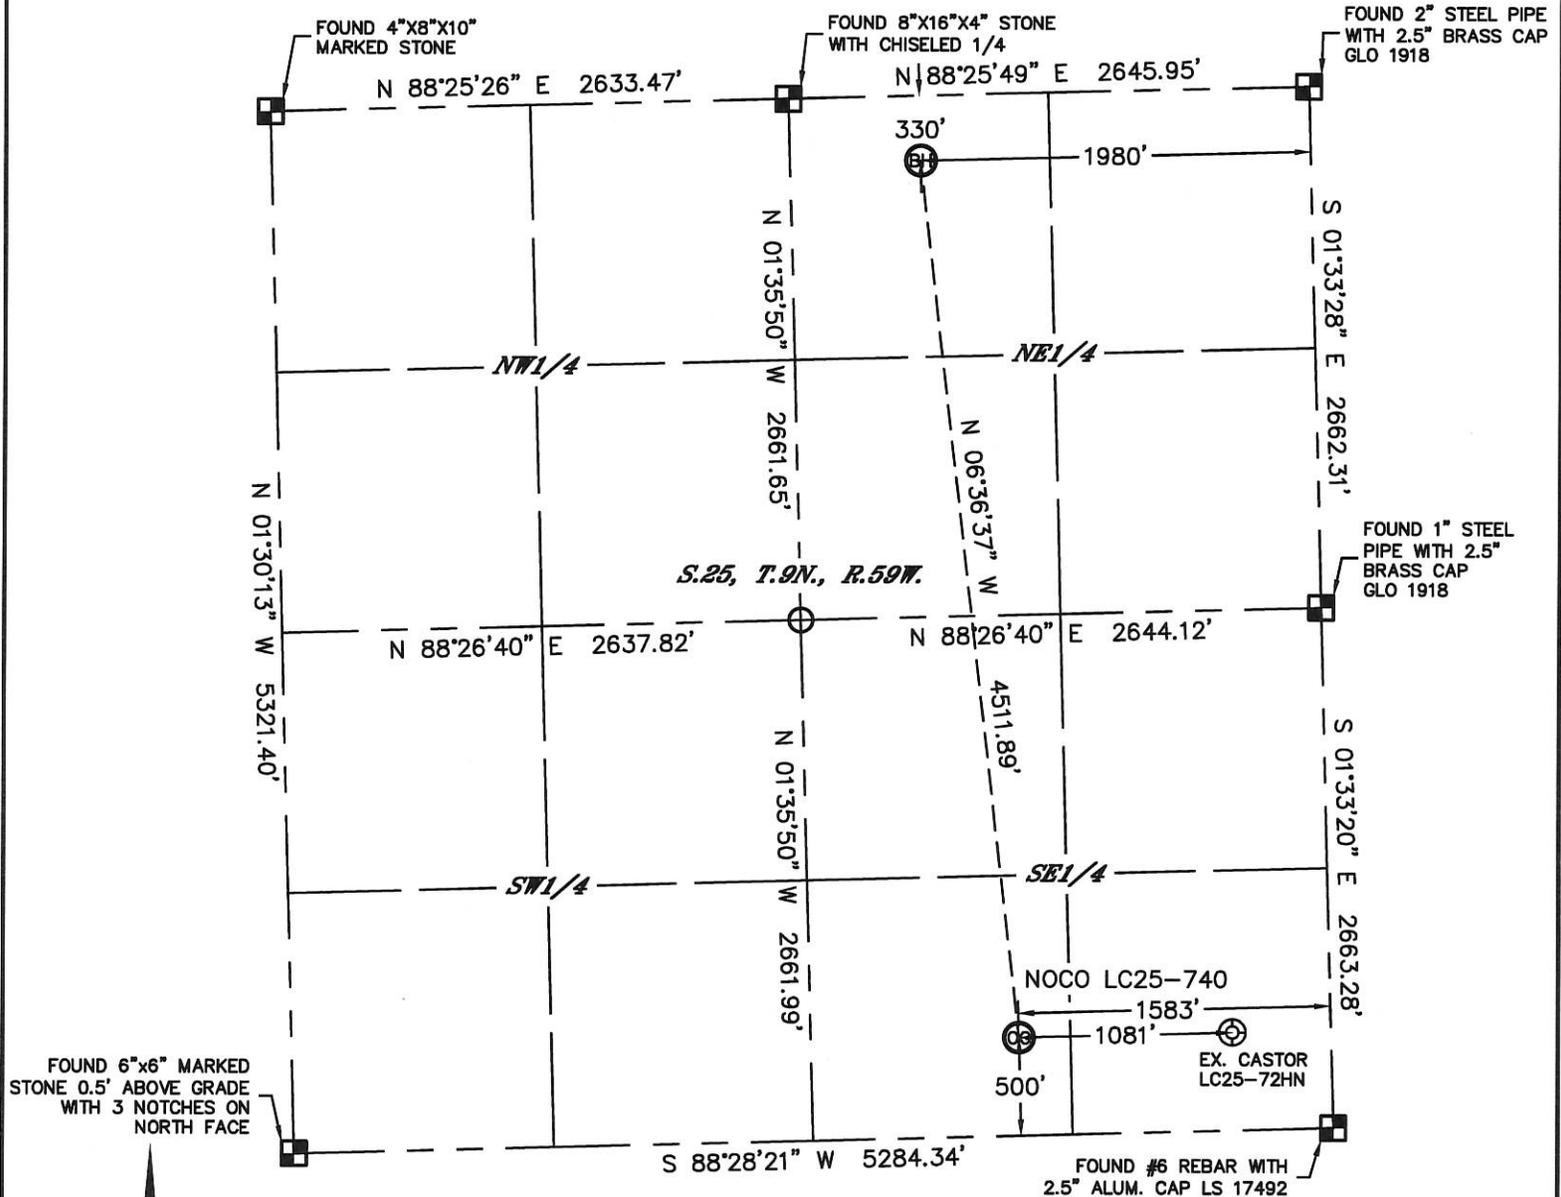

In accordance with a request from Cody Ball with Noble Energy Inc., Lat40°, Inc. has determined the surface location of the NOCO LC25-740 to be 500' from the SOUTH line and 1583' from the EAST line and the bottom hole to be 330' from the NORTH line and 1980' from the EAST line as measured at right angles from the section lines of Section 25, Township 9 North, Range 59 West of the Sixth Principal Meridian, County of Weld, State of Colorado.

I hereby state that this Well Location Certificate was prepared by me, or under my direct supervision, that the fieldwork was completed on 2/15/2014, for and on behalf of Noble Energy Inc. That this is not a Land Survey Plat or an Improvement Survey Plat, and that it is not to be relied upon for establishment of fence, building, or other future improvement lines.


- NOTE:
- 1) Bearings shown are Grid Bearings of the Colorado State Plane Coordinate System, North Zone, North American Datum 1983/2007. The lineal dimensions as contained herein are based upon the "U.S. Survey Foot."
 - 2) Ground elevations are based on an observed GPS elevation (NAVD 1988 DATUM).
 - 3) IMPROVEMENTS: See LOCATION DRAWING for all visible improvements within 500' of disturbed area.
 - 4) SURFACE USE: RANGELAND
 - 5) INSTRUMENT OPERATOR: BRIAN ROTTINGHAUS
 - 6) NEAREST EXISTING WELL: CASTOR LC25-72HN, 1081' E
NEAREST CULTURAL ITEMS:
BUILDING: 5280'+
BUILDING UNIT: 5280'+
HIGH OCCUPANCY BUILDING UNIT: 5280'+
DESIGNATED OUTSIDE ACTIVITY AREA: 5280'+
PUBLIC ROAD: 5280'+
ABOVEGROUND UTILITY: 415' S
RAILROAD: 5280'+
PROPERTY LINE: 500' S

SURFACE LOCATION
LAT: 40.71584°N
LONG: 103.92213°W
PPOP: 2.1
ELEV: 4901'
1/4,1/4: SW1/4SE1/4

BOTTOM HOLE
LAT: 40.72816°N
LONG: 103.92372°W

LEGEND

- = ALIQUOT MONUMENT AS DESCRIBED
- = CALCULATED POSITION

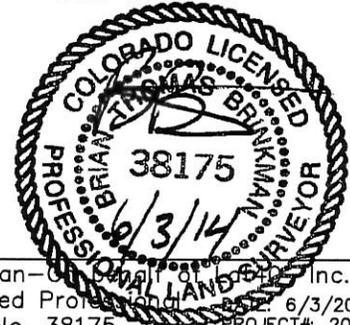



Colorado Licensed Professional Land Surveyor No. 38175
Date: 6/3/2014
PROJECT#: 2013186



SITE SKETCH

NOCO LC25-740

SECTION: 25
TOWNSHIP: 9N
RANGE: 59W

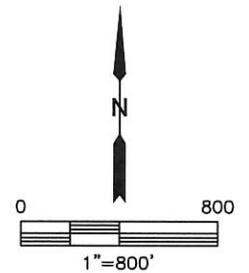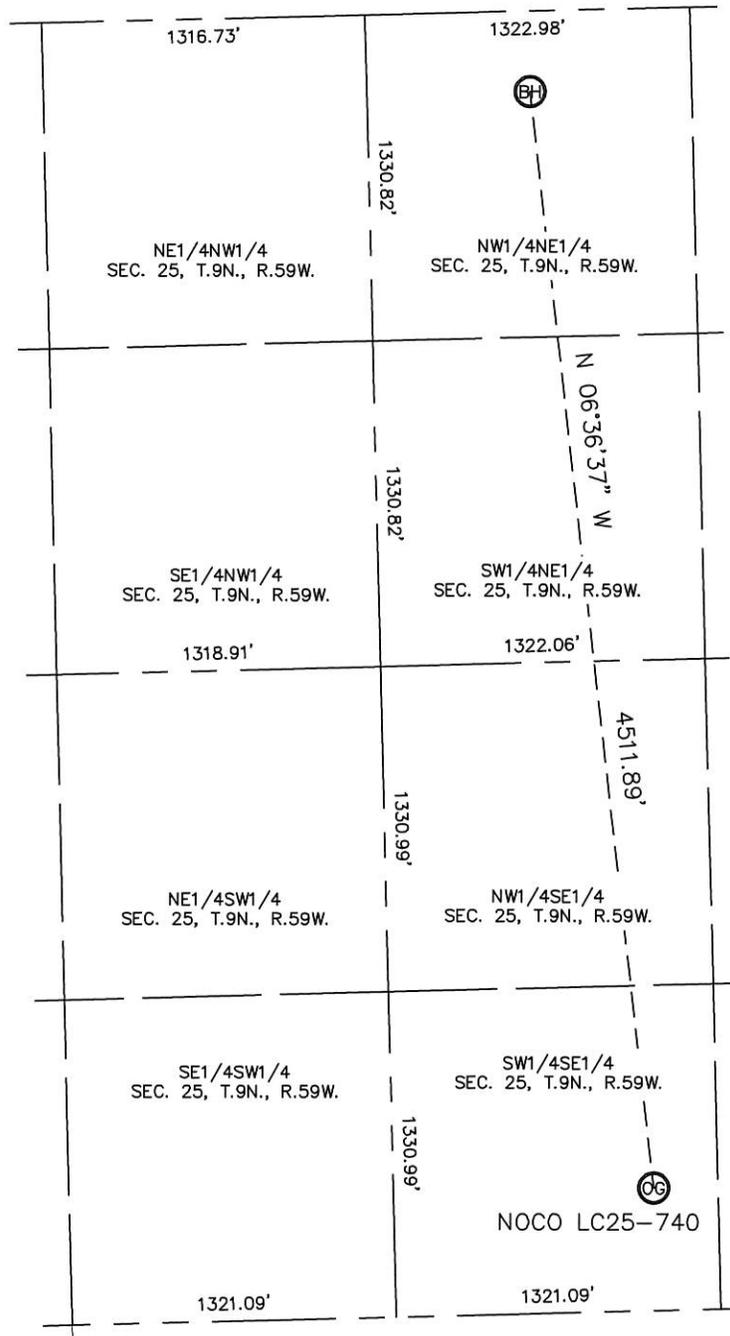

NOTE: NO EXISTING WELLS ADJACENT TO PROPOSED WELL BORE.