




# WELL LOCATION CERTIFICATE

THIS MAP DOES NOT REPRESENT A BOUNDARY SURVEY


SECTION: 34  
TOWNSHIP: 9N  
RANGE: 59W

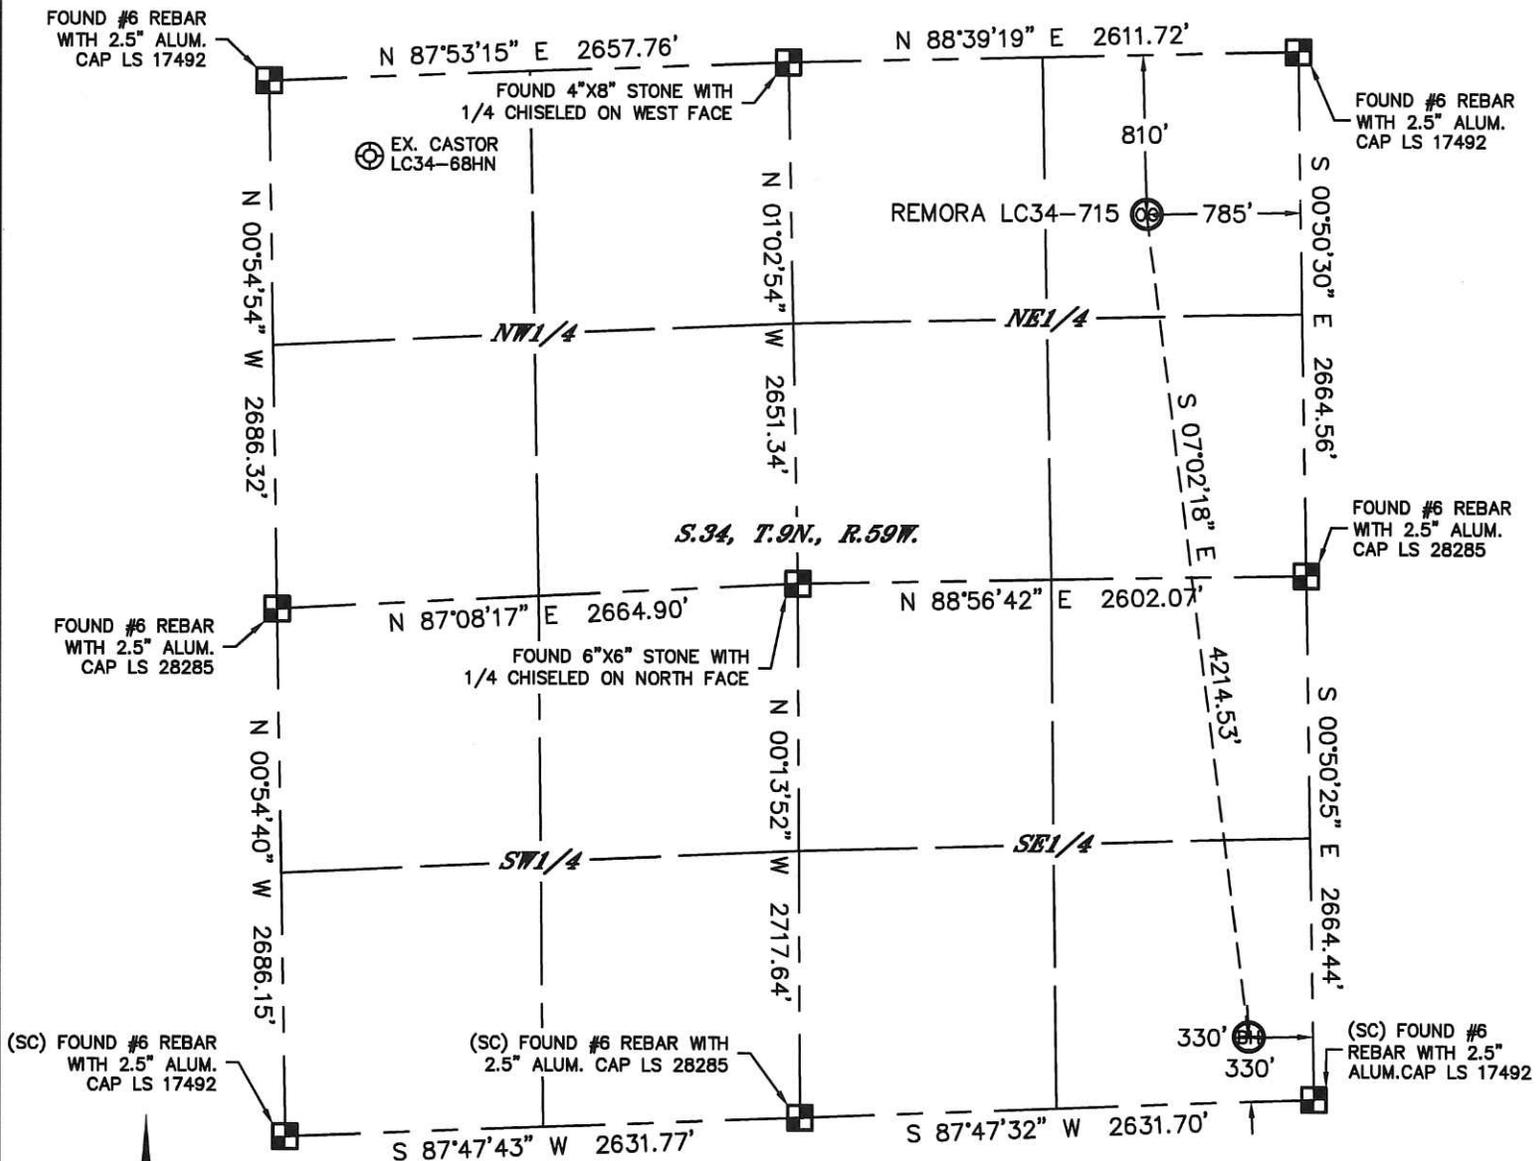

*S.34, T.9N., R.59W.*

In accordance with a request from Brian James with Noble Energy Inc. Lat40°, Inc. has determined the surface location of the REMORA LC34-715 to be 810' from the NORTH line and 785' from the EAST line and the bottom hole to be 330' from the SOUTH line and 330' from the EAST line as measured at right angles from the section lines of Section 34, Township 9 North, Range 59 West of the Sixth Principal Meridian, County of Weld, State of Colorado.

I hereby state that this Well Location Certificate was prepared by me, or under my direct supervision, that the fieldwork was completed on 2/13/2014, for and on behalf of Noble Energy Inc. That this is not a Land Survey Plat or an Improvement Survey Plat, and that it is not to be relied upon for establishment of fence, building, or other future improvement lines.

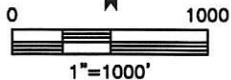

NOTE:

- 1) Bearings shown are Grid Bearings of the Colorado State Plane Coordinate System, North Zone, North American Datum 1983/2007. The lineal dimensions as contained herein are based upon the "U.S. Survey Foot."
  - 2) Ground elevations are based on an observed GPS elevation (NAVD 1988 DATUM).
  - 3) IMPROVEMENTS: See LOCATION DRAWING for all visible improvements within 500' of disturbed area.
  - 4) SURFACE USE: RANGELAND
  - 5) INSTRUMENT OPERATOR: BRIAN ROTTINGHAUS
  - 6) NEAREST EXISTING WELL: CASTOR LC34-68HN, 3997' NW
- NEAREST CULTURAL ITEMS:  
 BUILDING: 5280'+  
 BUILDING UNIT: 5280'+  
 HIGH OCCUPANCY BUILDING UNIT: 5280'+  
 DESIGNATED OUTSIDE ACTIVITY AREA: 5280'+  
 PUBLIC ROAD: 5280'+  
 ABOVEGROUND UTILITY: 858' N  
 RAILROAD: 5280'+  
 PROPERTY LINE: 520' S

SURFACE LOCATION  
 LAT: 40.71206°N  
 LONG: 103.95708°W  
 PDOP: 1.9  
 ELEV: 4814'  
 1/4,1/4: NE1/4NE1/4

BOTTOM HOLE  
 LAT: 40.70056°N  
 LONG: 103.95548°W

LEGEND

- = ALIQUOT MONUMENT AS DESCRIBED
- = CALCULATED POSITION



Brian T. Brinkman, Inc.  
 Colorado Licensed Professional Land Surveyor No. 38175  
 DATE: 5/29/2014  
 PROJECT#: 2013186