




WELL LOCATION CERTIFICATE


THIS MAP DOES NOT REPRESENT A BOUNDARY SURVEY

SECTION: 34
TOWNSHIP: 9N
RANGE: 59W

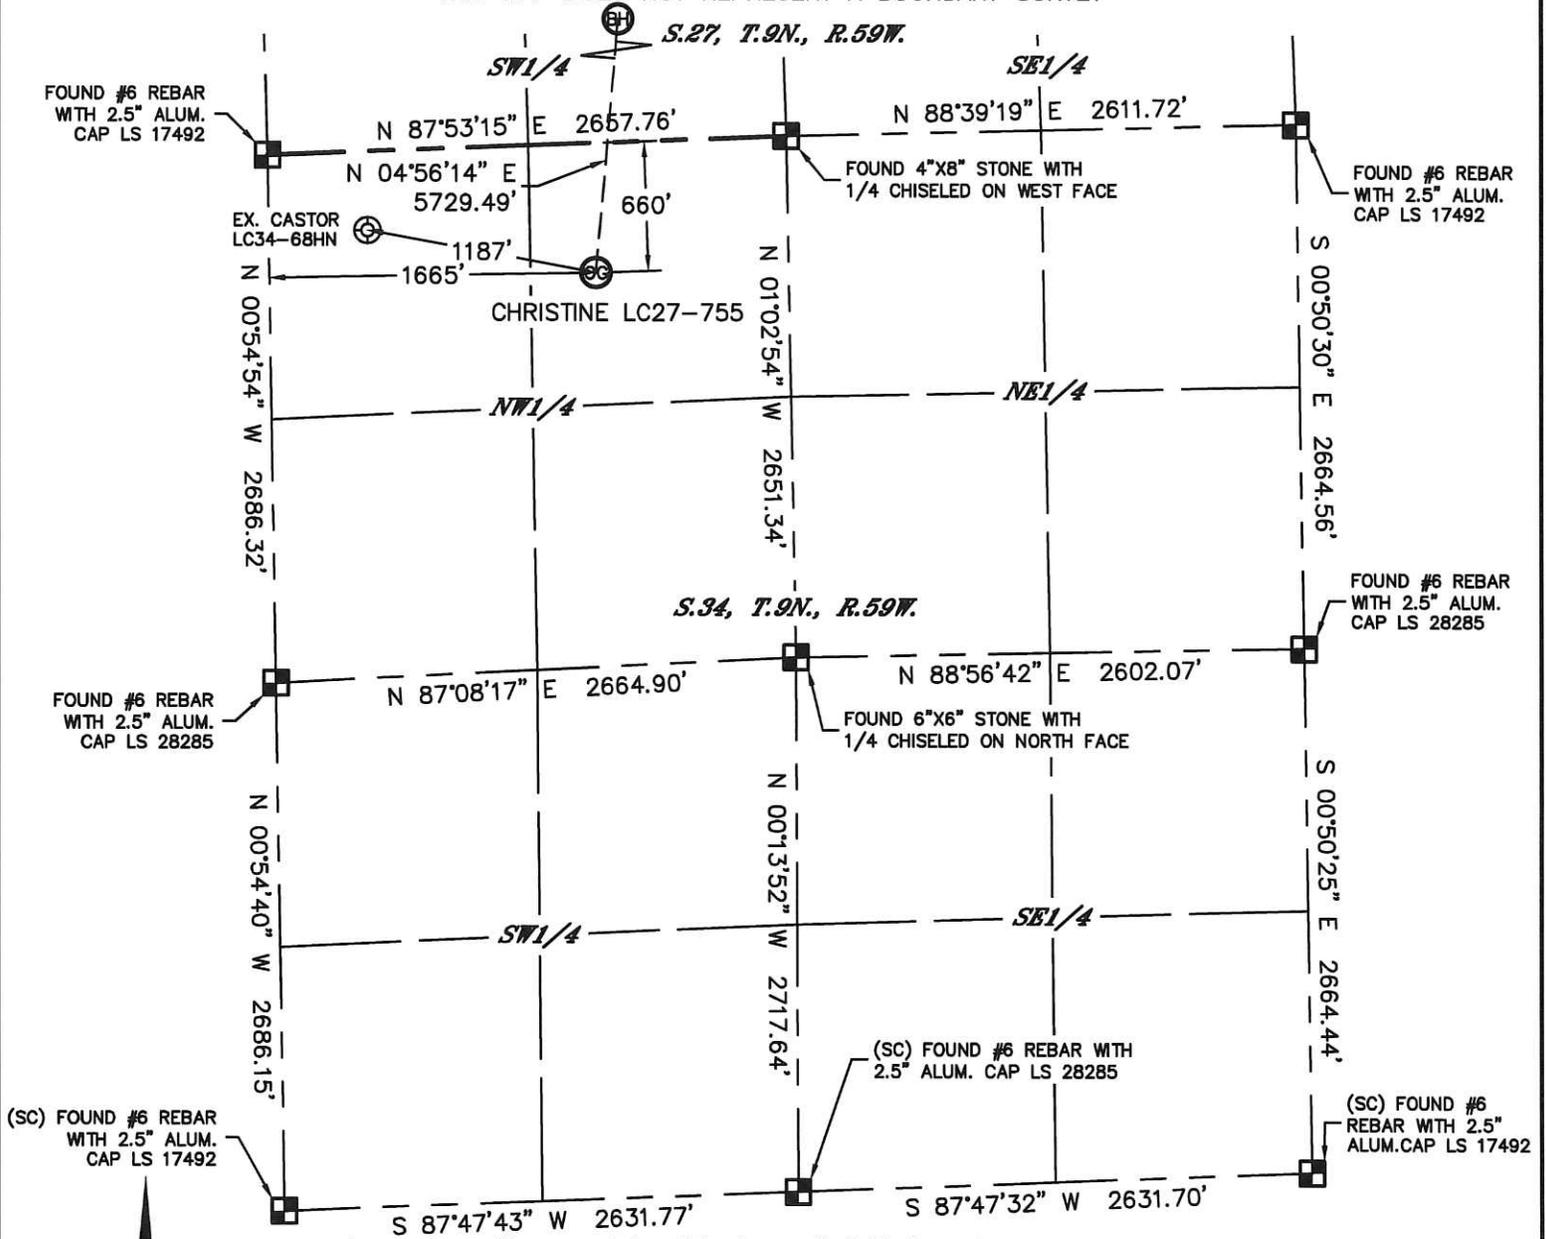

In accordance with a request from Brian James with Noble Energy Inc. Lat40°, Inc. has determined the surface location of the CHRISTINE LC27-755 to be 660' from the NORTH line and 1665' from the WEST line as measured at right angles from the section lines of Section 34, Township 9 North, Range 59 West and the bottom hole to be 330' from the NORTH line and 2310' from the WEST line as measured at right angles from the section lines of Section 27, Township 9 North, Range 59 West of the Sixth Principal Meridian, County of Weld, State of Colorado.

I hereby state that this Well Location Certificate was prepared by me, or under my direct supervision, that the fieldwork was completed on 2/7/2014, for and on behalf of Noble Energy Inc. That this is not a Land Survey Plat or an Improvement Survey Plat, and that it is not to be relied upon for establishment of fence, building, or other future improvement lines.

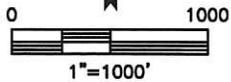

NOTE:

- 1) Bearings shown are Grid Bearings of the Colorado State Plane Coordinate System, North Zone, North American Datum 1983/2007. The lined dimensions as contained herein are based upon the "U.S. Survey Foot."
 - 2) Ground elevations are based on an observed GPS elevation (NAVD 1988 DATUM).
 - 3) IMPROVEMENTS: See LOCATION DRAWING for all visible improvements within 500' of disturbed area.
 - 4) SURFACE USE: RANGELAND
 - 5) INSTRUMENT OPERATOR: BRIAN ROTTINGHAUS
 - 6) NEAREST EXISTING WELL: CASTOR LC34-68HN, 1187' NW
- NEAREST CULTURAL ITEMS:
 BUILDING: 5280'+
 BUILDING UNIT: 5280'+
 HIGH OCCUPANCY BUILDING UNIT: 5280'+
 DESIGNATED OUTSIDE ACTIVITY AREA: 5280'+
 PUBLIC ROAD: COUNTY ROAD 115, ±5033' SW
 ABOVEGROUND UTILITY: 701' N
 RAILROAD: 5280'+
 PROPERTY LINE: 660' N

SURFACE LOCATION
 LAT: 40.71239°N
 LONG: 103.96724°W
 PDOP: 1.6
 ELEV: 4827'
 1/4,1/4: NE1/4NW1/4

BOTTOM HOLE
 LAT: 40.72803°N
 LONG: 103.96510°W

LEGEND

- = ALIQUOT MONUMENT AS DESCRIBED
- = CALCULATED POSITION

SHEET 1 OF 2

Brian T. Brinkman—
 Colorado Licensed Professional Land Surveyor, Inc.
 Land Surveyor No. 38175







WELL LOCATION CERTIFICATE

THIS MAP DOES NOT REPRESENT A BOUNDARY SURVEY

SECTION: 34
TOWNSHIP: 9N
RANGE: 59W

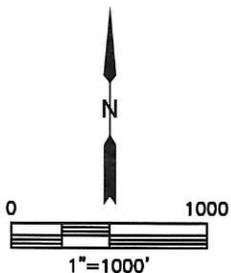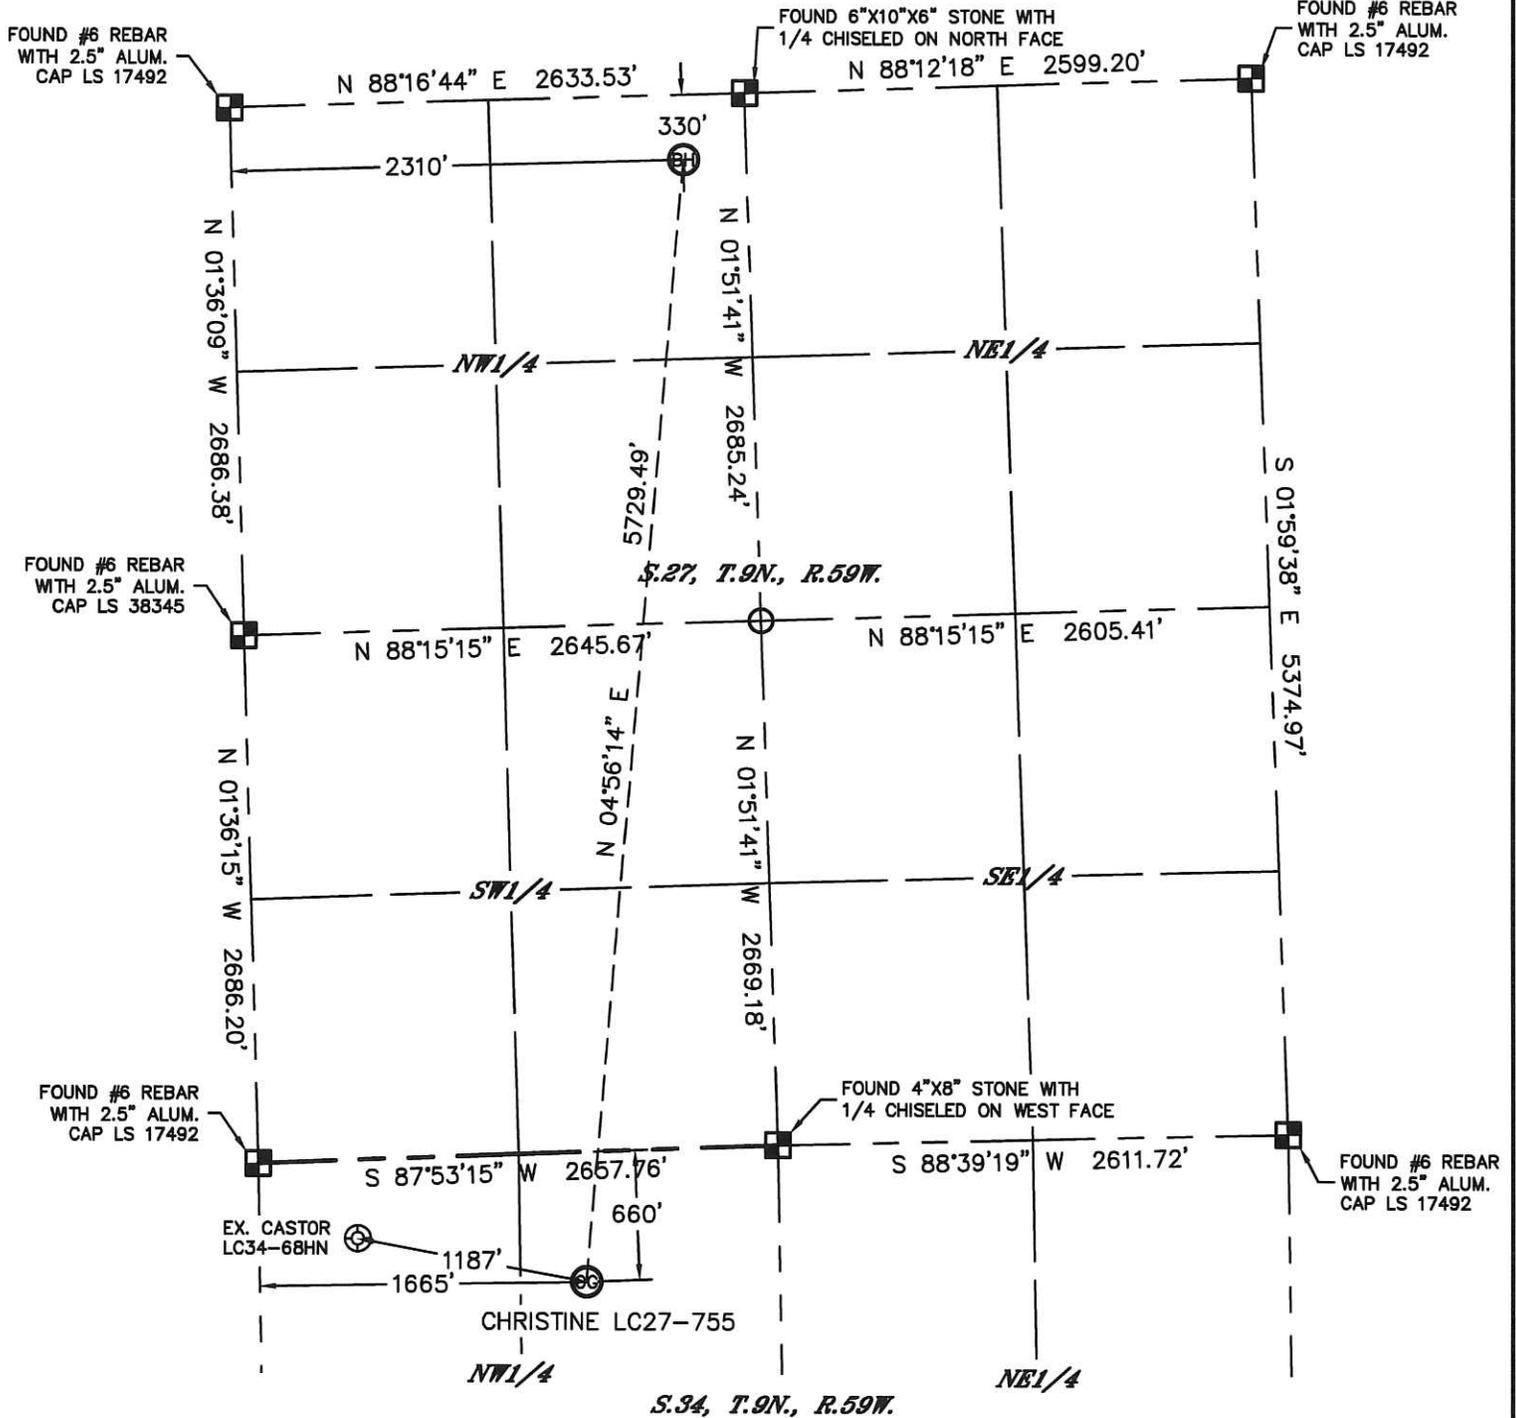

- LEGEND
- = ALIQUOT MONUMENT AS DESCRIBED
 - = CALCULATED POSITION

SHEET 2 OF 2

Brian T. Brinkman
 Colorado Licensed Professional Land Surveyor
 Land Surveyor No. 38175

